

INSTRUCTIONS

1. Original and/or subsequent record used to evaluate the corner position.
2. Description of evidence found, note discrepancies in the record, state method of establishing lost or obliterated corners.
3. Description of monument and accessories set to perpetuate the corner position.
4. Sketch of corner, show all pertinent data which can best be shown in a sketch example, corner marking, topography ties, position of accessories, etc.
5. Certification must be signed and sealed by Land Surveyor registered in the State of Montana.
6. Fill in Cross Index & Section Diagram at bottom of sheet.

CERTIFIED CORNER RECORDATION

Corner Section 29,30,31, & 32 T. 31N R. 31W "P.M.M. Lincoln County

1. 1893 G.L.O. RECORD Set a slatestone 14X10X6 ins. 10 ins. in the ground for cor. to secs. 29, 30, 31, and 32, marked with 1 notch on S. and 5 notches on E. edges; from which

A fir 12 ins. diam. bears N71°E 73 lks. dist. marked T31N R31W S29 BT.

A tamarack 16 ins. diam. bears S55°E 71 lks. dist. marked T31N R31W S32 BT.

A fir 8 ins. diam. bears S52°W 41 lks. dist. marked T31N R31W S31 BT.

A fir 10 ins. diam. bears N39°W 37 lks. dist. marked T31N R31W S30 BT.

1962 BLM REMONUMENTATION The corner of secs. 29, 30, 31, and 32, monumented with an unmarked argillite stone 15X8X6 ins. firmly set in a mound of stone and witnessed by the remains of three of the original bearing trees.

At the corner point

Set an iron post 30 ins. long 2 1/2 ins. diam. 25 ins. in the ground, with cap mkd.

T31N R31W
S30, S29
S31, S32
1962

from which

The new bearing trees:

A cedar 10 ins. diam. bears N60°E 48 lks. dist. mkd T31N R31W S29 BT.

A fir 18 ins. diam. bears S55°W 28 lks. dist. mkd T31N R31W S31 BT.

A fir 18 ins. diam. bears N56°W 35 lks. dist. mkd T31N R31W S30 BT.

bury the original stone alongside and raise a flat mound of stone 3 ft. diam. around the iron post.

1982 CERTIFIED CORNER RECORDATION by T.Hill 5612-S Verified 1962 BLM record.

- II. Found B.L.M. cap on iron post 4 ins. out of ground with loose mound of stone. Cap marked as shown above, from which;

A douglas fir 22 ins. diam. bears N55°W 23.8 ft. dist. with healed face.

A douglas fir 20 ins. diam. bears S57°W 22.3 ft. scribed W S31 BT.

A 5.2 ft. high 19 ins. diam. stump bears S54°E 46.4 ft. dist. with healed face.

A cedar 13 ins. diam. bears N60°E 34.5 ft. dist. scribed R31W S29 BT.


- III. Set a guard post, with a "Survey Marker" decal attached, 2 ft. S. from corner.

from which

The new bearing tree

A douglas fir 8 ins. diam. bears S21°E 25.9 ft. scribed T31N R31W S32 BT.

Painted a red band around each bearing tree and attached "Attention" and "Bearing Tree" signs where needed.

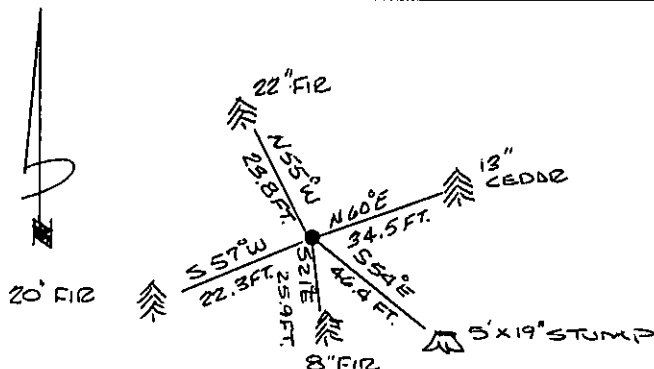

SKETCH OF CORNER

CERTIFICATION

I, Larry M. Hinkle

certify the information herein is true and correct.

THOMAS C. HILL

I, Thomas C. Hill
certify that this Corner Record correctly represents work performed by me or under my direction in compliance with the "Corner Recordation Act" (MCA 101-101, 102, 103, 104, 1902, 19

INSTRUCTIONS TO SURVEYORS FOR COMPLETION OF CERTIFIED CORNER RECORDATION FORMS

I. ORIGINAL AND/OR SUBSEQUENT RECORD:

This item should describe or quote those portions of the original or subsequent record which were used in evaluating the corner position. The original record will usually be the General Land Office field notes. Subsequent record can come from several sources: Previously filed corner records, maps and plats, private and public records, etc. Some of the subsequent record, even though not in the public record, but known to have validity by the surveyor, may be quoted and appropriately noted.

The record data helps support the reestablished corner position because it clearly shows what history the surveyor based his corner position on. In some cases, however, the record may be unknown or not pertinent. A statement to that effect should appear on the corner record.

II. DESCRIPTION OF EVIDENCE FOUND OR METHOD OF LOCATING CORNER POSITION:

This item will describe the original or subsequent record evidence found. If portions of the found evidence cannot be reconciled with the record, then the disregarded record should be noted, and, if possible, an opinion as to its cause narrated.

If no physical evidence of the original or subsequent monuments and accessories can be found, then the method used to reestablish the lost or obliterated corner (single proportion, fence intersection, parol evidence, terrain calls, centerline of road, etc.) **shall** be indicated.

III. DESCRIPTION OF MONUMENTS AND ACCESSORIES SET TO PERPETUATE THE CORNER POSITION:

This item should list all details about the corner and its location which will help exclusively identify the corner position; including size and type of monument, how marked if not shown in sketch, and distinguishing topographic calls which help locate the corner. In many cases, instructions on how to find the corner should be included.

References or ties to other corners are optional and may be drawn on the face or back of the corner record form, or references to Certificate of Survey may be made. Separate drawings may be attached to the corner form.

If state plane coordinate values for the corner position are shown, then the control upon which they are based should be indicated.

IV. SKETCH OF CORNER:

This item will usually show how a found or set corner is marked and may also show topography or accessory monuments found or set and their relation to the corner. There is no stipulated format; the sketch could be transcribed field note entries.

V. CERTIFICATION:

The name and signature of the ground party chief is optional.

The Surveyor who performed or directed the field work which is depicted on the "Certified Corner Record" shall sign and affix his seal in the Certification.

The employer blank is optional but useful in tracking down original field note data or adjacent record if, in the future, questions arise about the corner.

VI.

The Cross Index at the bottom of the page should be completed by the Surveyor. Only the single Township Index where the corner is filed shall be completed.

The lower righthand corner is a corner location diagram and should have the pertinent section filled in at the top and a closed circle indicating the appropriate corner position in the section filled in. This is intended to be an aid in searching the "Record" once it has been filed.