

## INSTRUCTIONS

1. Original and/or subsequent record used to evaluate the corner position.
2. Description of evidence found, note discrepancies in the record, state method of establishing lost or obliterated corners.
3. Description of monument and accessories set to perpetuate the corner position.
4. Sketch or corner, show all pertinent data which can best be shown in a sketch example, corner marking, topography ties, position of accessories, etc.
5. Certification must be signed and sealed by Registered Land Surveyor in State of Montana.
6. Fill in Cross Index & Section Diagram at bottom of sheet.

## CERTIFIED CORNER RECORDATION

Corner W1/16 between Sections 20 and 29 T. 31 N. R. 31 W. P.M.M. Lincoln Co

I. Record: Certificate of Survey No. 1062 and Certified Corner Recordation by J. H. Ninneman filed on July 31, 1980:

"Set 5/8" x 24" Steel Rod with Cap Stamped J.H.N. 4661S

24" Ponderosa Pine Bears S  $46^{\circ}$  E 55.8 Ft. Scribed S 20 W 1/16  
B.T. & Posted.

8" Ponderosa Pine Bears N  $30^{\circ} 30'$  E 28.8 Ft. Scribed S 29 W 1/16  
B.T. & Posted

II. Found: Steel Rod with cap 3" below pavement surface, from which a


28" Ponderosa Pine stump with scribing visible brs. N  $42^{\circ}$  W 56.0  
ft. (note discrepancy from original record)

12" Ponderosa Pine with scribing visible brs. S  $30^{\circ} 30'$  W 28.8  
ft. (note discrepancy in bearing from original record)

III. Perpetuation: Establish two new references as follows:

A spike, 14" up from the ground, in the the East side of a 20"  
diam. power pole, tagged PPL3131 202062, brs. N  $13^{\circ}$  E 40.31  
feet.

A spike, 12" up from the ground, in the West side of a 16"  
untagged power pole brs. S  $26^{\circ}$  E, 16.07 feet.

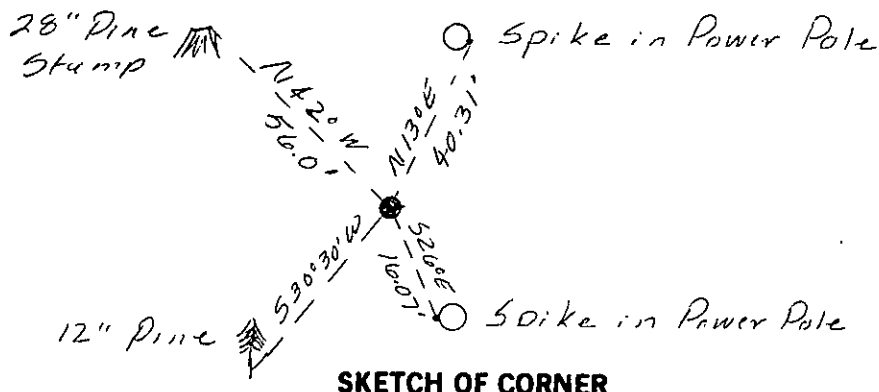

SKETCH OF CORNER

## CERTIFICATION

I, Linda S. Smith  
certify the information shown herein is true and correct.

Linda S. Smith  
Signature Ground Party Chief

I, Thomas Sands  
certify that this Corner Record correctly represents work performed  
by me or under my direction in compliance with the "Corner  
Recordation Act" (70-22-101, et seq., M.D.A.)

Thomas Sands  
Signature of Surveyor & Seal

Date: 10/87 Reg. No. 79753


Employer: SANDS SURVEYING

Office of Clerk and Recorder, County of Lincoln. This "corner  
record" was filed for record on the Oct 29 day of 1987  
was noted on the cross-index plat and is assigned page No. 3690, in  
book No. \_\_\_\_\_

Janet B. Suggs  
County Official Deputy

Cross Index No. R-6 T. 31 N. R. 31 W. P.M.M.

Sec. 20

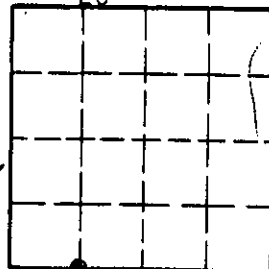

• - corner this sheet

# INSTRUCTIONS TO SURVEYORS FOR COMPLETION OF CERTIFIED CORNER RECORDATION FORMS

## I. ORIGINAL AND/OR SUBSEQUENT RECORD:

This item should describe or quote those portions of the original or subsequent record which were used in evaluating the corner position. The original record will usually be the General Land Office field notes. Subsequent record can come from several sources: Previously filed corner records, maps and plats, private and public records, etc. Some of the subsequent record, even though not in the public record, but known to have validity by the surveyor, may be quoted and appropriately noted.

The record data helps support the reestablished corner position because it clearly shows what history the surveyor based his corner position on. In some cases, however, the record may be unknown or not pertinent. A statement to that effect should appear on the corner record.

## II. DESCRIPTION OF EVIDENCE FOUND OR METHOD OF LOCATING CORNER POSITION:

This item will describe the original or subsequent record evidence found. If portions of the found evidence cannot be reconciled with the record, then the disregarded record should be noted, and, if possible, an opinion as to its cause narrated.

If no physical evidence of the original or subsequent monuments and accessories can be found, then the method used to reestablish the lost or obliterated corner (single proportion, fence intersection, parol evidence, terrain calls, centerline of road, etc.) shall be indicated.

## III. DESCRIPTION OF MONUMENTS AND ACCESSORIES SET TO PERPETUATE THE CORNER POSITION:

This item should list all details about the corner and its location which will help exclusively identify the corner position; including size and type of monument, how marked if not shown in sketch, and distinguishing topographic calls which help locate the corner. In many cases, instructions on how to find the corner should be included.

References or ties to other corners are optional and may be drawn on the face or back of the corner record form, or references to Certificate of Survey may be made. Separate drawings may be attached to the corner form.

If state plane coordinate values for the corner position are shown, then the control upon which they are based should be indicated.

## IV. SKETCH OF CORNER:

This item will usually show how a found or set corner is marked and may also show topography or accessory monuments found or set and their relation to the corner. There is no stipulated format; the sketch could be transcribed field note entries.

## V. CERTIFICATION:

The name and signature of the ground party chief is optional.

The Surveyor who performed or directed the field work which is depicted on the "Certified Corner Record" shall sign and affix his seal in the Certification.

The employer blank is optional but useful in tracking down original field note data or adjacent record if, in the future, questions arise about the corner.

## VI.

The Cross Index at the bottom of the page should be completed by the Surveyor. Only the single Township Index where the corner is filed shall be completed.

The lower righthand corner is a corner location diagram and should have the pertinent section filled in at the top and a closed circle indicating the appropriate corner position in the section filled in. This is intended to be an aid in searching the "Record" once it has been filed.

