

INSTRUCTIONS

1. Original and/or subsequent record used to evaluate the corner position.
2. Description of evidence found, note discrepancies in the record, state method of establishing lost or obliterated corners.
3. Description of monument and accessories set to perpetuate the corner position.
4. Sketch of corner, show all pertinent data which can best be shown in a sketch example, corner marking, topography ties, position of accessories, etc.
5. Certification must be signed and sealed by Land Surveyor registered in the State of Montana.
6. Fill in Cross Index & Section Diagram at bottom of sheet.

CERTIFIED CORNER RECORDATION


CORNER NO. 3
 Corner H.E.S. 935 Section 14 T. 31N R. 32 W P.M.M. Lincoln County

- I. 1919 USDA Forest Service Homestead Entry Survey Original Record: Set a small stone marked with a cross (x) under a limestone rock, 26x8x6 ins. 16 ins. in the ground, marked 3 HES 935 on the NE face MC on the south face, and a cross (x) on top for the exact corner point, from which,
 A cross (x) on a tamarack tree 16 ins. dia. bears N68°38'E 114 lks. dist.
 A cross (x) on a cedar tree 7 ins. dia. bears N88°09'W, 7 lks. dist; each blazed and scribed MC 3 HES 935 BT.
 Raised a mound of stone 4 ft. base 2 ft. high on succeeding course 3½ ft dist.
1982 Corner Recordation Filed Lincoln Co. by 33258: Found stone 26x8x6 inches laying on ground marked 3 HES 935, X on top of stone; no witness marks found.
- II. I found 26x8x6 ins. stone laying on its side along riverbank, markings visible. From which the rotten remains of leaning cedar stump bears N70°W 7.3 lks. with partial visible scribe.
- III. Corners No. 4,5 and found BT were measured and compared to record, Corner 3 was set record from Cor.4 and the dist. to the found BT. The dist. 7.3 lks compared to record 7.0 lks but due to the riverbank erosion the BT shifted and the bearing N70°W compared to record N88°09'W. I set a 2 ins. diam. by 30 ins. long aluminum pipe with a 3½ ins. diam. aluminum cap 27 ins. in the ground surrounded by stone collar and mkd. as shown;

T31N R32W
 HES
 935
 COR 3
 MC
 5612-S
 1986

Bury original stone alongside pipe. Set a 6 ft. galvanized steel post with a " Survey Marker and Property Boundary" decal attached, N20°E 2.3 ft. from corner.

- I blazed one BT and located one BO;
 A cedar 26 ins. diam. bears N3°W 78 ft. marked MC3 HES 935 BT
 Power Pole #142200 with pk nail on south side bears S89°E 63.9 ft.
 I painted scribing on BT and attached BT signs to both BT and BO and attached Land Survey Monument sign.

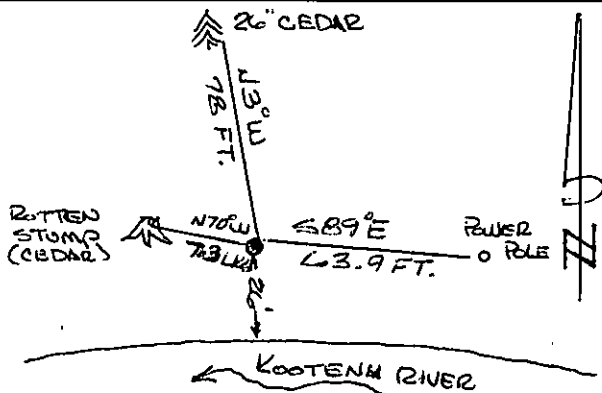

SKETCH OF CORNER

CERTIFICATION

I, Gary C. Crismon
 certify the information shown herein is true and correct.

MONTANA
 LAND SURVEYORS

I, Thomas C. Hill
 certify that this corner recordation represents work performed by me or under my direction in compliance with the "Corner Recordation Act" (70-2-101, et seq., M.C.A.)

Date: 6/86
 Employer: U.S.D.A. FOREST SERVICE

Office of Clerk and Recorder, County of Lincoln. This "corner record" was filed for record on June 10, 1986 was noted on the cross-index plat and is assigned page No. 3261, in book No. _____

Printed BT Sign by Bill Buckoff
 County Official

Sec. 14

Cross Index No. _____ T. _____ R. _____ PMM • corner this sheet

INSTRUCTIONS TO SURVEYORS FOR COMPLETION OF CERTIFIED CORNER RECORDATION FORMS

I. ORIGINAL AND/OR SUBSEQUENT RECORD:

This item should describe or quote those portions of the original or subsequent record which were used in evaluating the corner position. The original record will usually be the General Land Office field notes. Subsequent record can come from several sources: Previously filed corner records, maps and plats, private and public records, etc. Some of the subsequent record, even though not in the public record, but known to have validity by the surveyor, may be quoted and appropriately noted.

The record data helps support the reestablished corner position because it clearly shows what history the surveyor based his corner position on. In some cases, however, the record may be unknown or not pertinent. A statement to that effect should appear on the corner record.

II. DESCRIPTION OF EVIDENCE FOUND OR METHOD OF LOCATING CORNER POSITION:

This item will describe the original or subsequent record evidence found. If portions of the found evidence cannot be reconciled with the record, then the disregarded record should be noted, and, if possible, an opinion as to its cause narrated.

If no physical evidence of the original or subsequent monuments and accessories can be found, then the method used to reestablish the lost or obliterated corner (single proportion, fence intersection, parol evidence, terrain calls, centerline of road, etc.) shall be indicated.

III. DESCRIPTION OF MONUMENTS AND ACCESSORIES SET TO PERPETUATE THE CORNER POSITION:

This item should list all details about the corner and its location which will help exclusively identify the corner position; including size and type of monument, how marked if not shown in sketch, and distinguishing topographic calls which help locate the corner. In many cases, instructions on how to find the corner should be included.

References or ties to other corners are optional and may be drawn on the face or back of the corner record form, or references to Certificate of Survey may be made. Separate drawings may be attached to the corner form.

If state plane coordinate values for the corner position are shown, then the control upon which they are based should be indicated.

IV. SKETCH OF CORNER:

This item will usually show how a found or set corner is marked and may also show topography or accessory monuments found or set and their relation to the corner. There is no stipulated format; the sketch could be transcribed field note entries.

V. CERTIFICATION:

The name and signature of the ground party chief is optional.

The Surveyor who performed or directed the field work which is depicted on the "Certified Corner Record" shall sign and affix his seal in the Certification.

The employer blank is optional but useful in tracking down original field note data or adjacent record if, in the future, questions arise about the corner.

VI.

The Cross Index at the bottom of the page should be completed by the Surveyor. Only the single Township Index where the corner is filed shall be completed.

The lower righthand corner is a corner location diagram and should have the pertinent section filled in at the top and a closed circle indicating the appropriate corner position in the section filled in. This is intended to be an aid in searching the "Record" once it has been filed.