BY: BRYAN BLOCK'S SURVEYING
1223 KIENAS RD.
KALISPELL MT. 59901
PH:(406)755_3478

DATE: FEBRUARY 22ND, 1993
PURPOSE: ALIQUOT TWENTY

CERTIFICATE OF SURVEY

S1/2NE1/4SW1/4 SEC.21 T.36 N.,R.26 W.,P.M.,M., LINCOLN COUNTY

FOR: ROBERT W. BEASLY
OWNER: " " " "

DESCRIPTION: THE S1/2NE1/4SW1/4 OF SEC. 21 T.36N., R26W., P.M.,M., LINCOLN COUNTY
SUBJECT TO AND TOGETHER WITH A 60' PRIVATE ROAD AND UTILITY EASEMENT AS SHOWN HEREON.
SUBJECT TO AND TOGETHER WITH ALL EXISTING EASEMENTS OF RECORD.

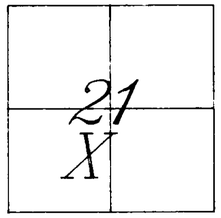

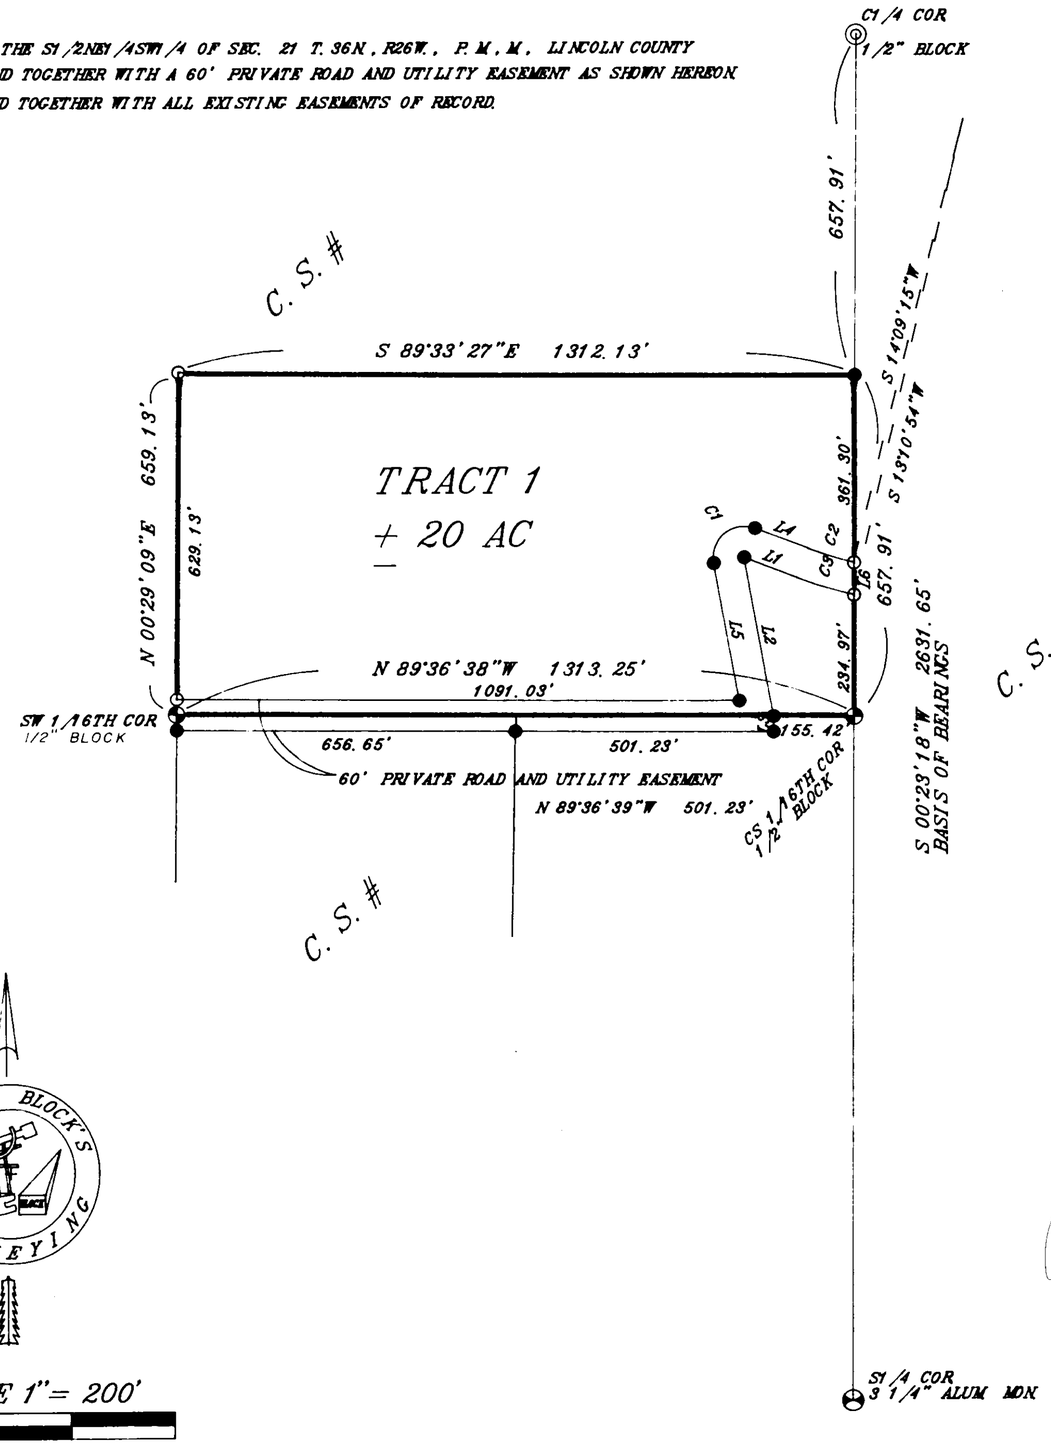

CURVE	DELTA ANGLE	RADIUS	ARC	TANGENT	CHORD	CHORD BEARING
C 1	121°06'45"	60.00'	126.83'	106.29'	104.50'	S 50°13'32"W
C 2	06°37'40"	804.25'	93.03'	46.57'	92.98'	N 72°31'55"W
C 3	07°36'01"	864.25'	114.64'	57.41'	114.56'	N 73°01'06"W

LINE	BEARING	DISTANCE
L 1	N 69°13'05"W	110.53'
L 2	S 10°19'50"E	311.64'
L 3	S 00°23'21"W	30.00'
L 4	N 69°13'05"W	110.53'
L 5	S 10°19'50"E	269.74'
L 6	S 00°23'18"W	61.65'

LEGEND

1 ⊗ SEC. CORNER
2 ◐ 1/4 CORNER
3 ◎ C1/4 CORNER
4 ◕ 1/16TH CORNER
5 ● FOUND 1/2" BLOCK
6 ○ SET 1/2"x5/8", REBAR 24" LONG WITH 1 1/4" ORANGE PLASTIC CAP, STAMPED BLOCK 7918_S

CERTIFICATE OF SURVEYOR
Bryan B. Block
REGISTRATION NO. 7918_S
APPROVED 3-30 1993
~~EXAMINING LAND SURVEYOR~~
Bill C. Brown
~~REGISTRATION NO.~~

STATE OF MONTANA
SS
COUNTY OF LINCOLN

FILED ON THE 30th DAY OF March
1993 A.D. AT 4:35 O'CLOCK p.m.
CLERK AND RECORDER
Coral R. Cummings
DEPUTY Jeannie Dennis
INSTRUMENT RECORD NO.
PAID
SHEET 1 OF 1 SHEET

Joe E. Williams
COUNTY COMMISSIONER

BRYAN BLOCK'S SURVEYING

SCALE 1"= 200'
0' 100' 200' 400' 600'

CERTIFICATE OF SURVEY NO. 2058