LINCOLN COUNTY
SEPTIC SYSTEM PERMIT NO. As Built

ISSUED TO: GARY FARNSWORTH DATE: 9-18-85

ADDRESS: [redacted] PHONE: [redacted]

ISSUED BY (sign.) Ronald L Anderson R.S.

INSPECTION BY (sign.) Ronald L Anderson R.S. DATE: 9-4-85

(You must notify the Department of Environmental Health a minimum of 8 working day hours before backfilling the septic system, so that it can be inspected.)

CONTRACTOR: —

DESCRIPTION OF SYSTEM:

LOCATION OF PROPOSED SYSTEM Sec. 28 T29N R33W (PAYNE CREEK - BEHIND BULL LAKE RESORT)


SEPTIC TANK 1500 gal. ABSORPTION AREA: 400 sq ft. ft²


SEWAGE DISCHARGE — gal/day No. OF BEDROOMS 4

WATER SUPPLY SOURCE WELL SOIL SANDY SILT W/ MIXED GRAVELS SLOPE 2-5%

INSTRUCTIONS: DIG A DITCH AT LEAST 200' IN LENGTH X 2½-3' DEEP X 2' WIDE ACCORDING TO LOT LAYOUT AND DITCH DIAGRAM.

SKETCH OF LOT LAYOUT:

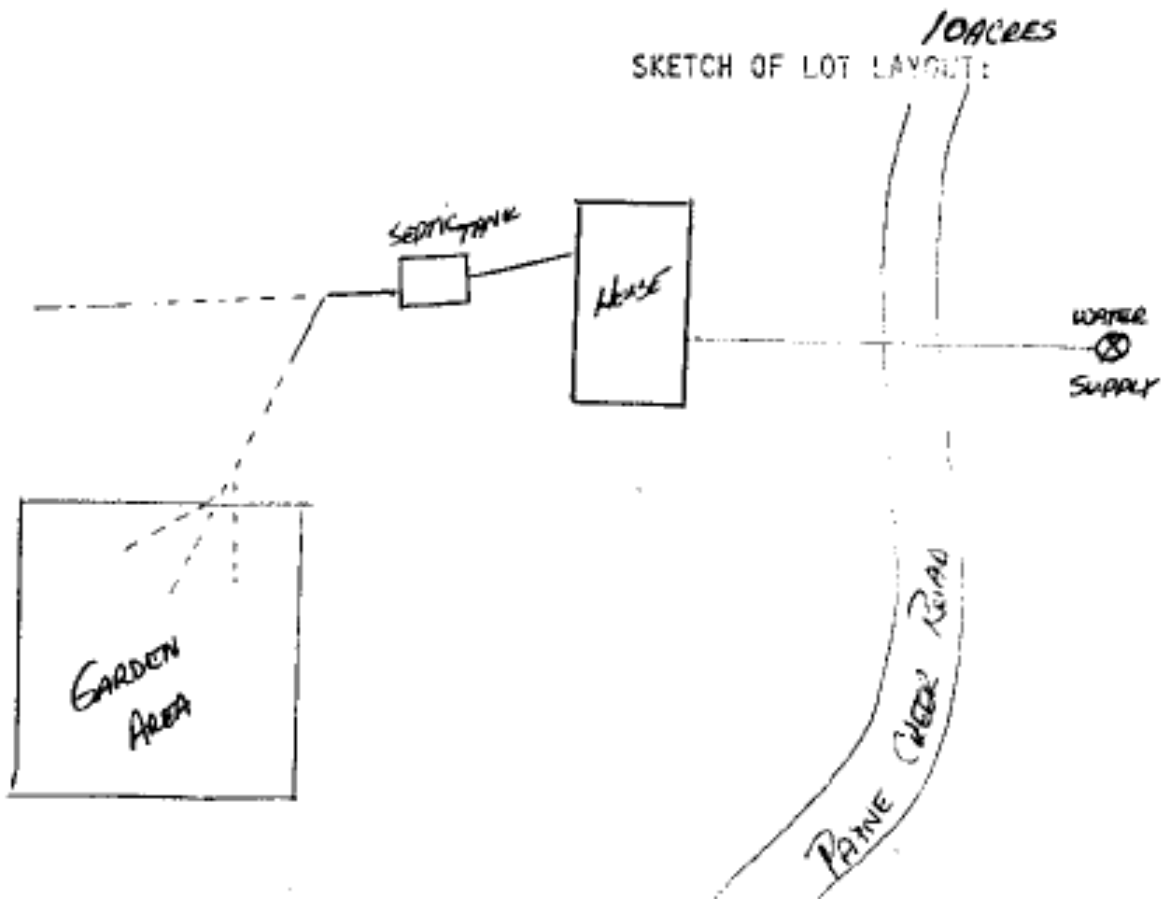

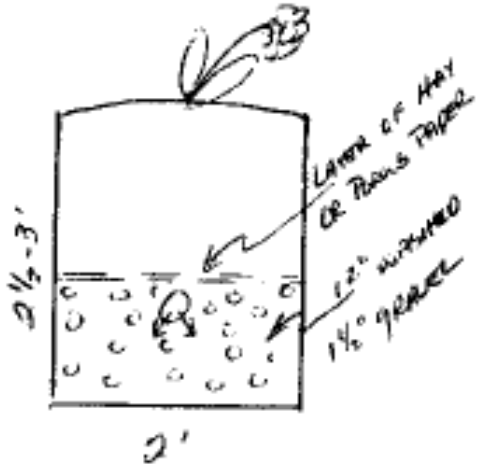

DITCH DIAGRAM