LINCOLN COUNTY
DEPARTMENT of ENVIRONMENTAL HEALTH
Wastewater Treatment and Disposal System
PERMIT

contractor Signs below

Issue Date: 8-17-99 Expiration Date: 8-17-00

Property Owner: GERALD AND MARGARET WALLACE

Address: [redacted]

Telephone: (Home) [redacted] (Work) _____

Installer: Bob Epperson License No. 77

_____ New Installation ✓ Existing System

_____ Repair ✓ Replacement _____ Extension _____ Other

Describe: _____

Parcel Description:

Legal: TUPHAM BEACH LOTS 23 E½W Sec 32 T29N R33W

Address or Location: 15820 BULLK RD

Approved Design Criteria:

Bedrooms 3 Septic Tank Size: 1000 gallons SEEPAGE BED ~~Drainfield~~ Size: 625 SQ ~~lineal~~ feet

INSTALL SYSTEM AS PER APPROVED SITE PLAN (LOT LAYOUT) AND LINCOLN COUNTY WASTEWATER REGULATION #3.

Special Instructions: Install Lift Station and Seepage Bed as per L.C. Wastewater Reg. Design Standards. Place 12" of washed sand in bed

Issued By: John W Peterson

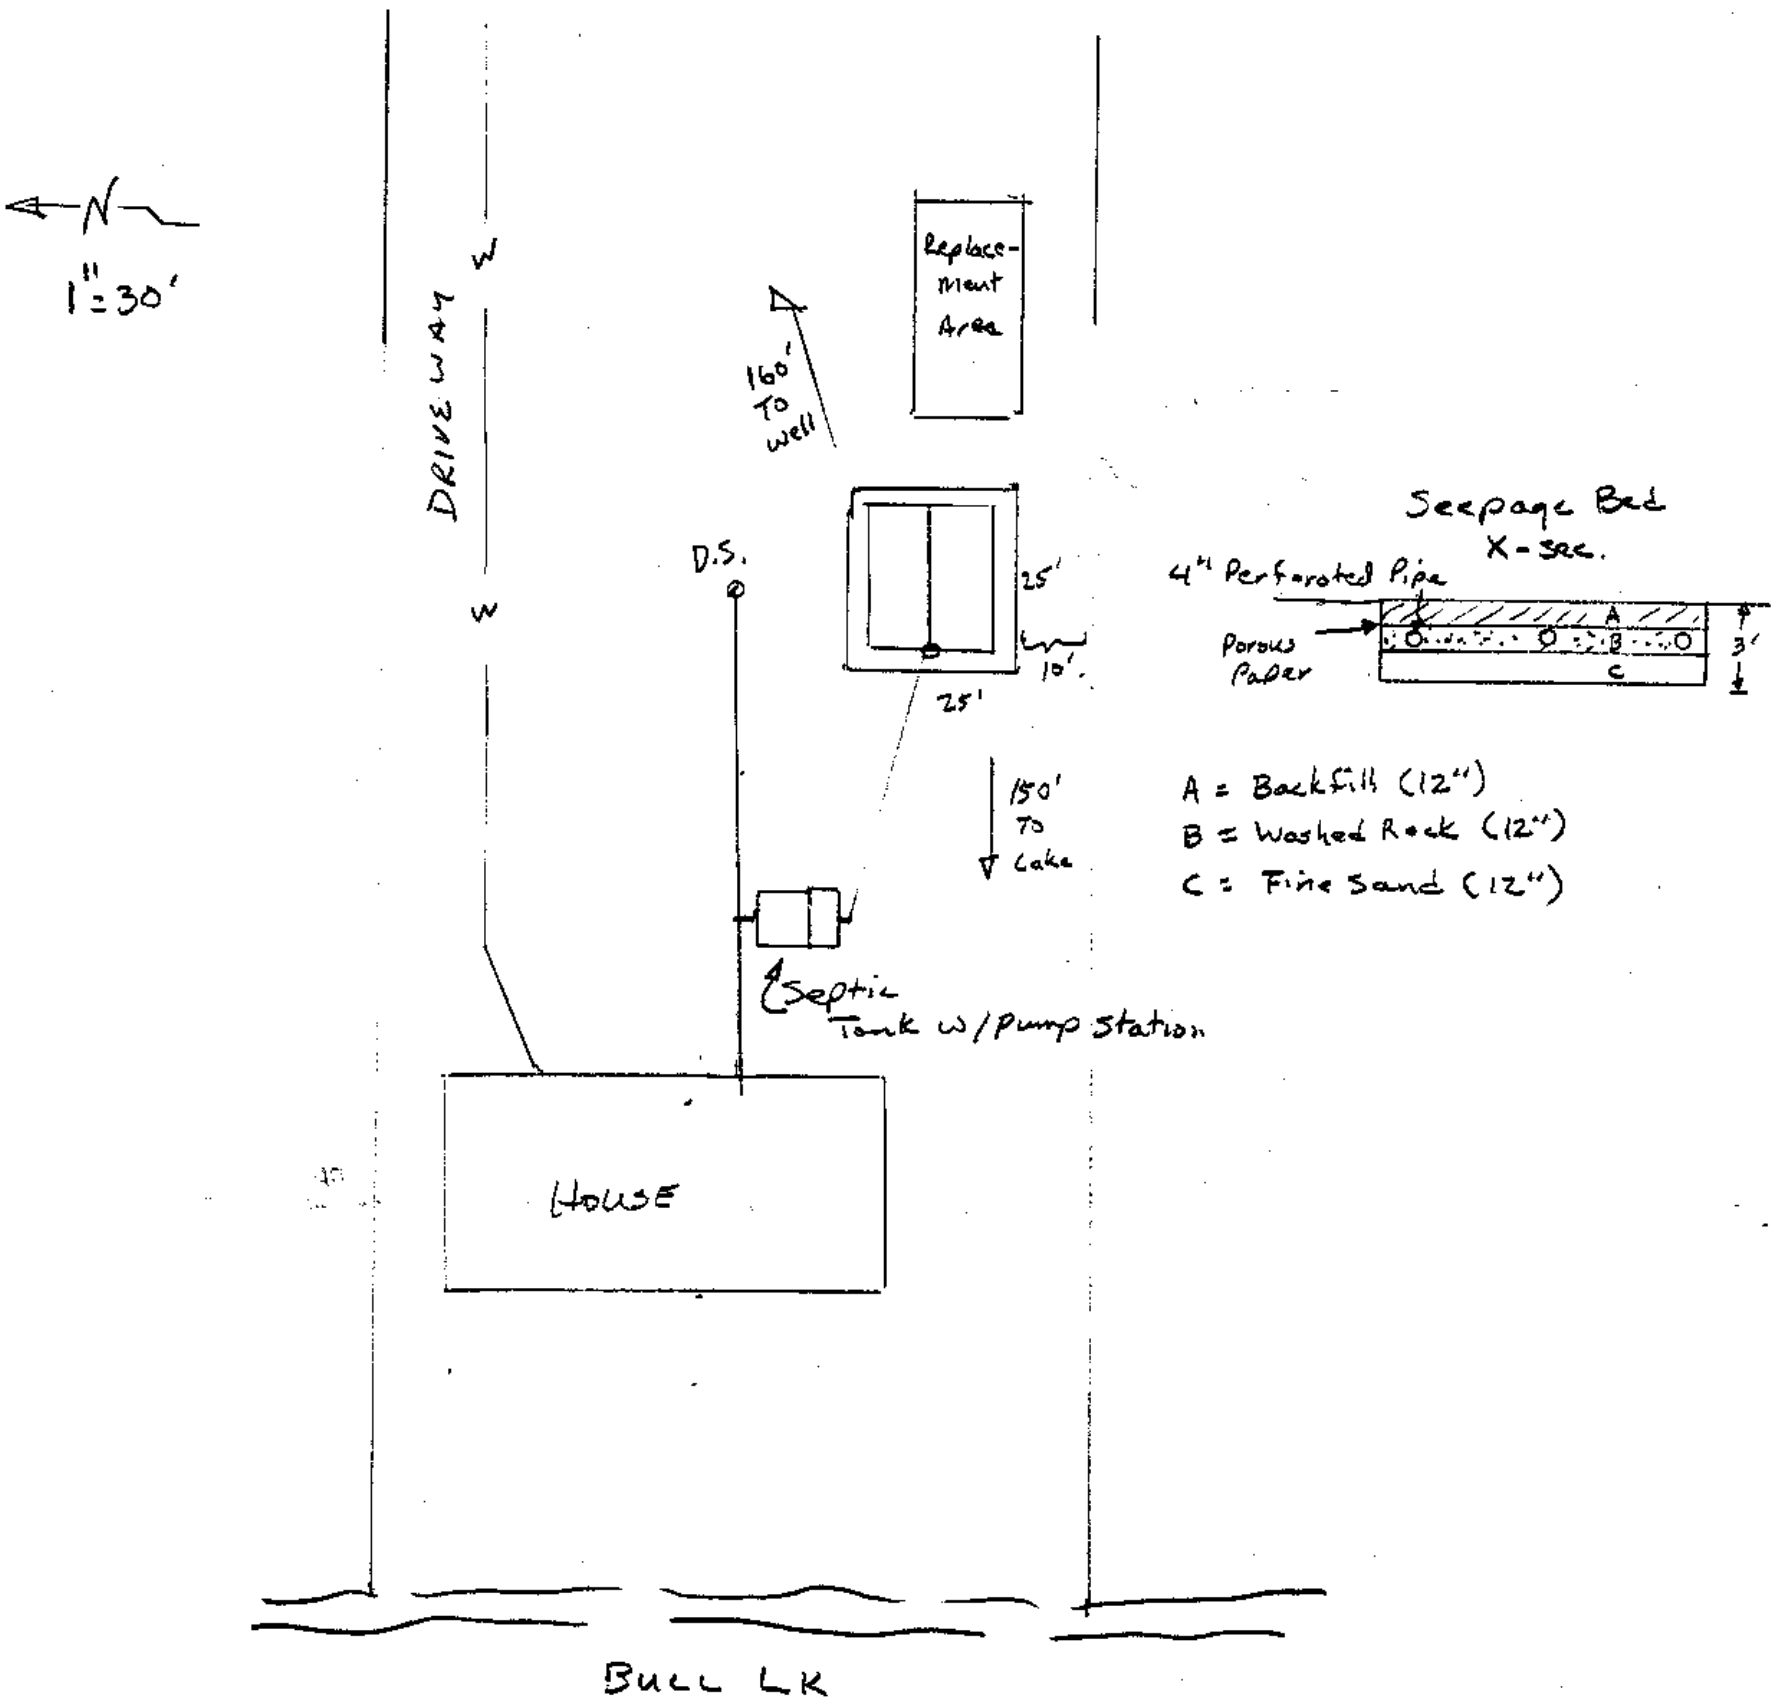
Closure Statement:

I, Robert H. Epperson have inspected this system and found it to be in compliance with the conditions of the permit, and the Lincoln County Wastewater Treatment and Disposal Regulation.

Signed: Robert H. Epperson Date: August 23, 1999

Title: Installer - inspector

LOT LAYOUT


N
1" = 30'
DRIVEWAY
W
W
Replace-
ment
Area
160'
To
well
D.S.
25'
10'
25'
150'
To
Lake
Septic
Tank w/Pump Station
HOUSE
BULL LK
Seepage Bed
X-sec.
4" Perforated Pipe
Porous
Paper
A
B
C
3'
A = Backfill (12")
B = Washed Rock (12")
C = Fine Sand (12")