LINCOLN COUNTY
DEPARTMENT OF ENVIRONMENTAL HEALTH
WASTEWATER TREATMENT AND DISPOSAL SYSTEM PERMIT

Issue Date: 08/01/2014 Expiration Date: 08/02/2015

Property Owner: Fub & Suanne Cubr c/o:

Address: [redacted]

Telephone: [redacted] (Work)

Installer: Dennis Riedlinger License No. 23

____ New Installation __XX__ Existing System

_____ Repair __XX__ Replacement_____ Extension _____ Other

Describe: Using gravelless chambers – sizing reduction allowed per "Drainfield Size" below.

Parcel Description:

Legal: Lot 2 in Block 4 of Angel Island

Address or Location: 454 Bethel Drive

Approved Design Criteria:

Bedrooms: 3 Septic Tank Size: 1000 gallons Drainfield Size: 192 Linear Feet

Installing three (3) 64-foot lines using Infiltrator chambers – provide as-built on completion.

SYSTEM MUST INCLUDE INSTALLATION OF EFFLUENT FILTER AT SEPTIC TANK OUTLET !!

Special Instructions: INSTALL SYSTEM ACCORDING TO LAYOUT, DEQ-4 AND LINCOLN COUNTY WASTEWATER REGULATION #3. ANY DEVIATIONS FROM APPROVED PLAN MUST BE AUTHORIZED BY THE DEPARTMENT.

Issued By: *Kendra J. Lind, R.S.*

Closure Statement:

I, DENNIS RIEDLINGER *, have inspected this system and found it to be in compliance with the conditions of the permit, and the Lincoln County Wastewater Treatment and Disposal Regulation.*

Signed: [signature] *Date:* 8/6/14

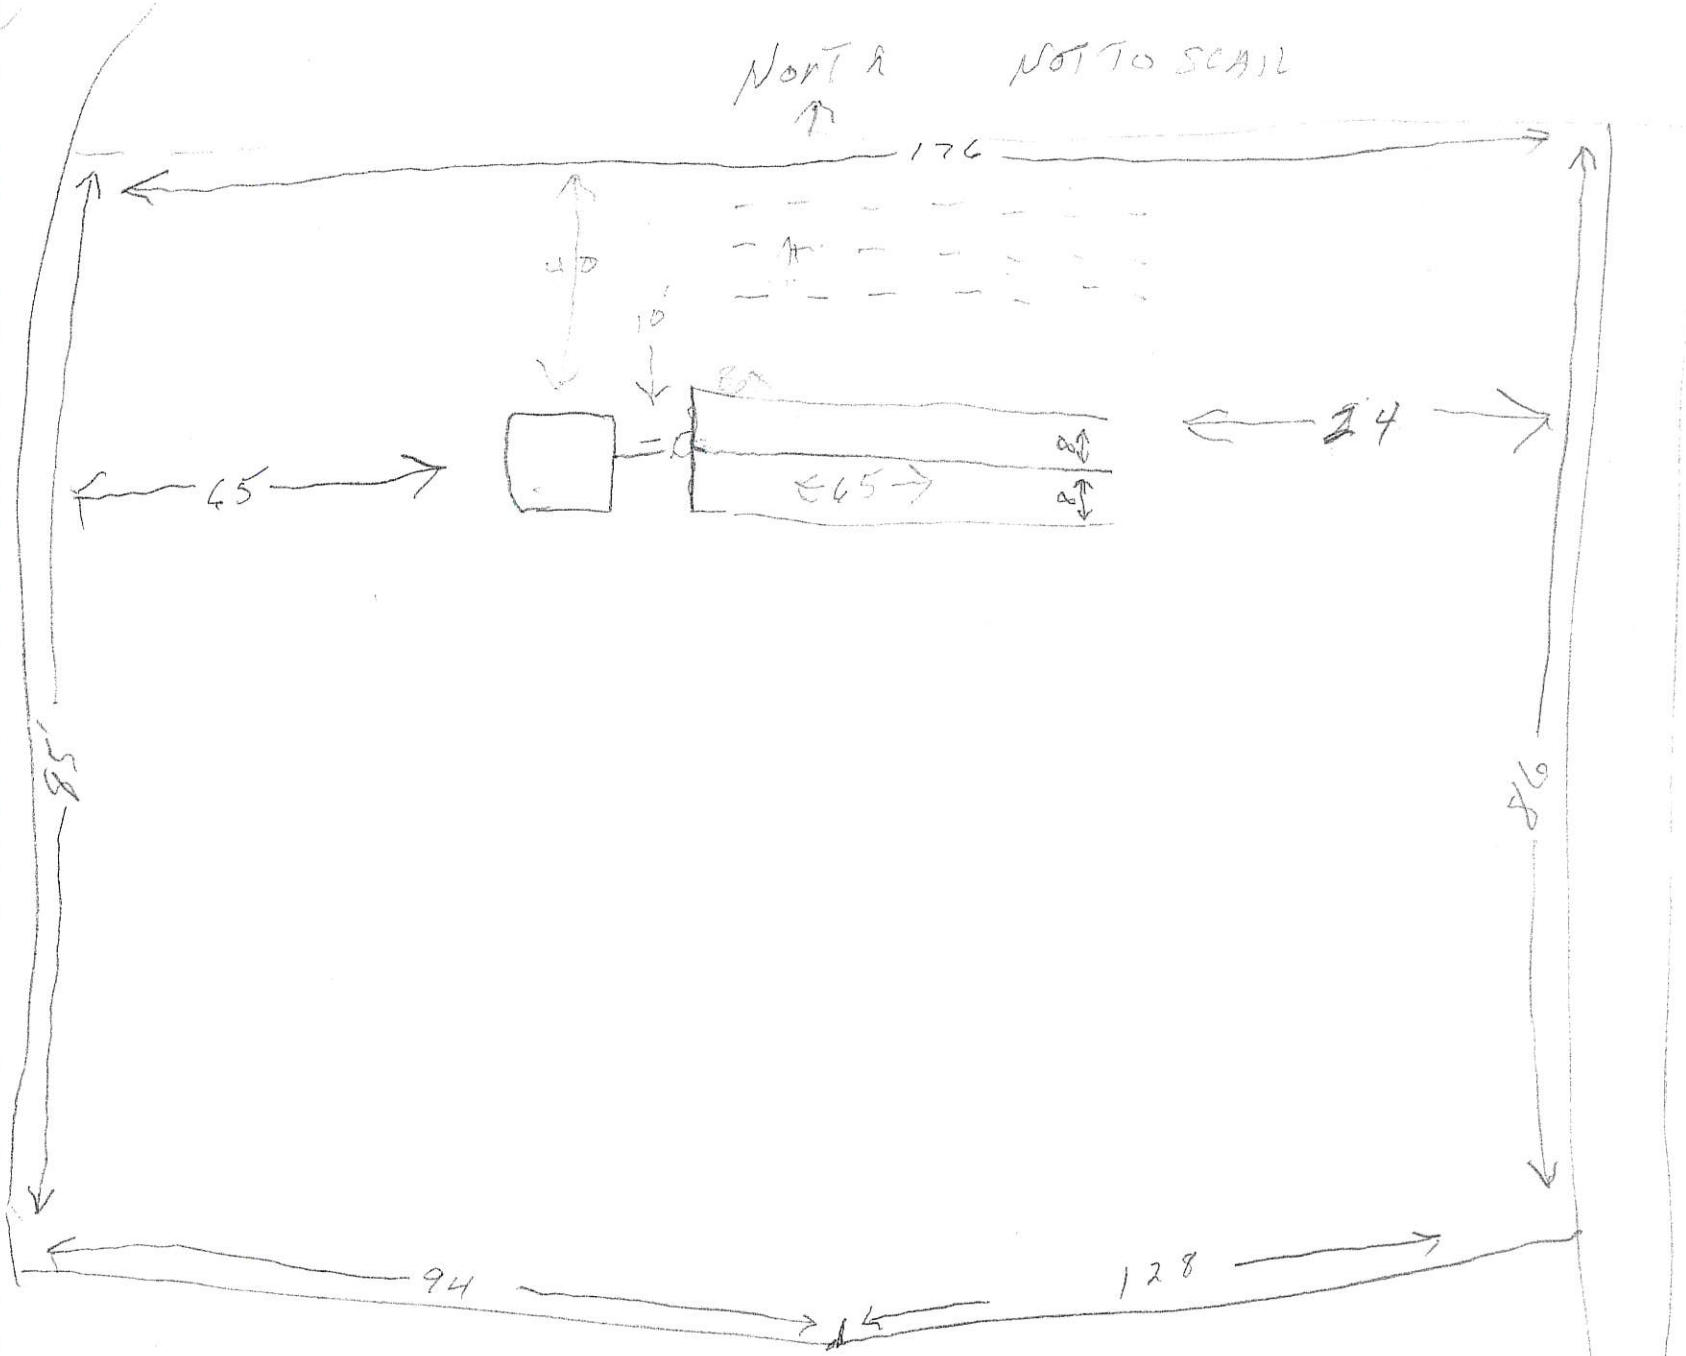
Title: OWNER

NOTICE: The Department must be notified at least 48 hours prior to backfilling the system. Any system not inspected by the Department or its designated representative prior to closure is an illegal installation in violation of Lincoln County Health Board Regulation No. 3. Illegal installations may result in fines and/or requirements to remove or reconstruct the system.

406-283-2442

DISCLAIMER

This permit is not a guarantee by the Department that the system will function properly for a prescribed period of time.


NORTH
NOT TO SCALE
176
40
10'
24
45
65
95'
96'
94
128