LINCOLN COUNTY 5776
DEPARTMENT OF ENVIRONMENTAL HEALTH
WASTEWATER TREATMENT AND DISPOSAL SYSTEM PERMIT

Issue Date: 07/25/05 Expiration Date: 07/26/06

Property Owner: Herbert & Camden DeMart [redacted]

Address: [redacted]

Telephone: [redacted] [redacted]

Installer: ~~Bill Merritt~~ TONY BROWN License No. ~~76~~ #55

__XX__ New Installation _____ Existing System

_____ Repair _____ Replacement _____ Extension _____ Other

Describe:

Parcel Description: WWW. NorLight.org

Legal:

Address or Location: Lot 3 in Block 3 of Angel Island

Approved Design Criteria:

Bedrooms 2 Septic Tank Size: 1000 gallons Drainfield Size: 150 Linear Feet

SYSTEM MUST INCLUDE INSTALLATION OF EFFLUENT FILTER AT SEPTIC TANK OUTLET !!

Special Instructions: INSTALL SYSTEM ACCORDING TO LAYOUT, DEQ-4 AND LINCOLN COUNTY WASTEWATER REGULATION #3. ANY DEVIATIONS FROM APPROVED PLAN MUST BE AUTHORIZED BY THE DEPARTMENT.

Issued By: Kendra J. Lind, R.S.

Closure Statement:

I, ANTHONY E. (TONY) BROWN *have inspected this system and found it to be in compliance with the conditions of the permit, and the Lincoln County Wastewater Treatment and Disposal Regulation.*

Signed: Anthony E. Brown *Date:* 8-1-06

Title: INSTALLER #55

NOTICE: The Department must be notified at least 48 hours prior to backfilling the system. Any system not inspected by the Department or its designated representative prior to closure is an illegal installation in violation of Lincoln County Health Board Regulation No. 3. Illegal installations may result in fines and/or requirements to remove or reconstruct the system.


406-293-7781

DISCLAIMER

This permit is not a guarantee by the Department that the system will function properly for a prescribed period of time.

SV

LOT LAYOUT
HERBERT & CAMDEN DEMART
LOT 38 IN BLOCK 3
ANGEL ISLAND

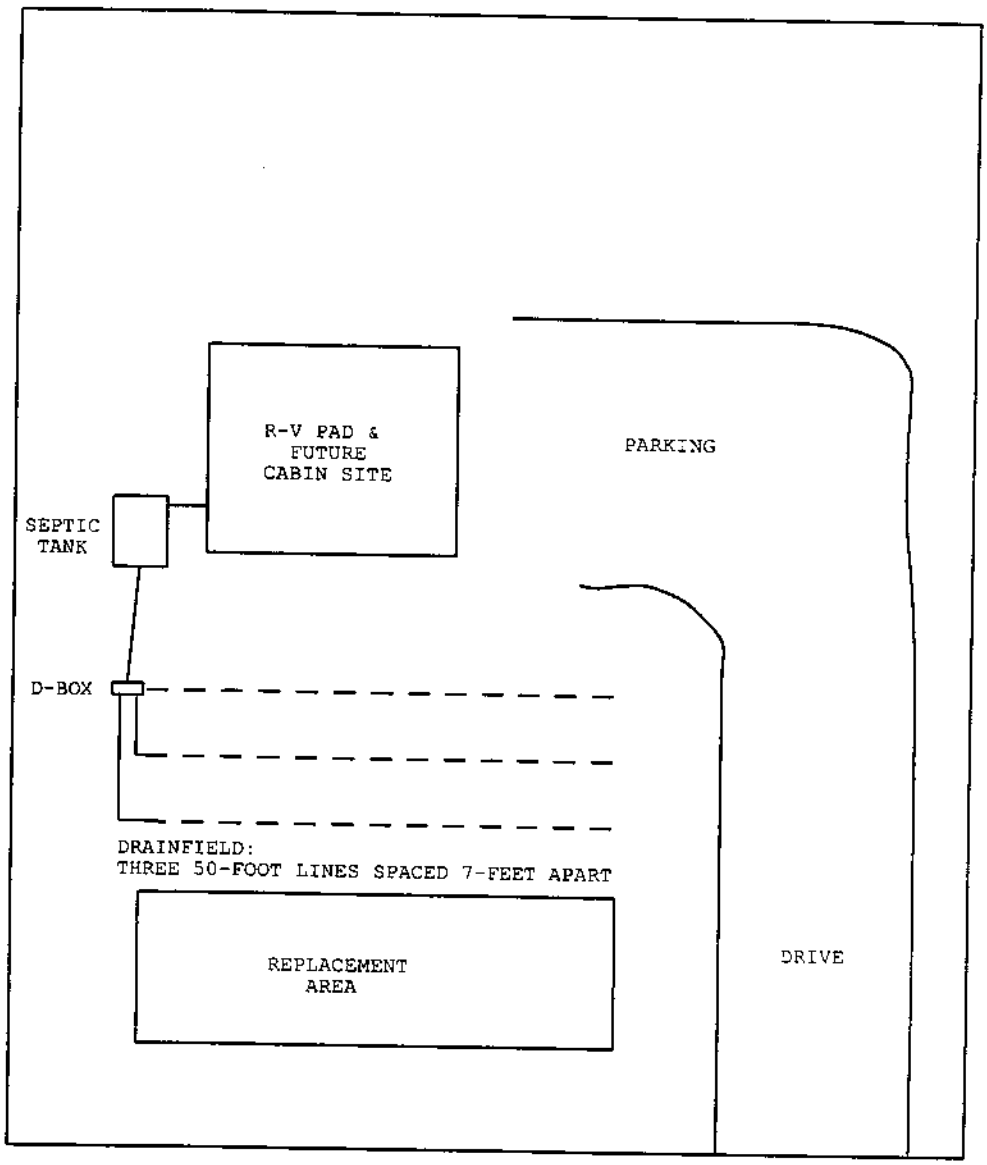

CHERUB LAKE ROAD

SCALE: 1" = 20'