LINCOLN COUNTY Permit #25-14004

DEPARTMENT OF ENVIRONMENTAL HEALTH

AFFIDAVIT OF WASTEWATER TREATMENT AND DISPOSAL SYSTEM COMPLIANCE REVIEW FOR SYSTEM INSTALLED, REPAIRED OR REPLACED WITHOUT A VALID PERMIT

Issue Date: 03/25/2025

Property Owner: Karen Wade

Mailing Address: [redacted]

Name of Person Who Installed System Being Reviewed: Koocanusa Plumbing License #

Type of System Work Reviewed:

_x_ New Installation ____ Existing System

____ Repair ____ Replacement ____ Extension ____ Other

Describe: New installation of gravity system for 3 Bedroom House with 3 laterals @ 90'.

Property Description:

Legal: S23, T35 N, R26 W, COS 3297, PARCEL C, ACRES 20, IN N2NWSW 14004

Address or Location: 720 Drop Tine Rd., Eureka, MT 59917

Reviewed Design Components: David Hull Jr.

Septic Tank: 1000 Gallon Effluent Filter: Yes

Dosing or Lift Tank: No Drainfield Size: 3 Laterals @90' Trench Depth: 36" Trench Width: 24"

Assessment code: 14004

Comments: System was installed in 2003 or 2004 and no septic permit on record.

System Review Documentation Statement:

I, Robin Blumberg, have reviewed the components of this system as listed above and found it to be in compliance with the sizing, construction, orientation and operating requirements of Chapter 17, Subchapter 9 A.R.M., Circular DEQ-4 and Lincoln County Wastewater Regulation #3.

Signed: Robin Blumberg *Date:* 3/25/25


Title: R. S.

NOTICE: This document is not a permit for installation, repair or alterations of a wastewater treatment system. It is merely a statement of affirmation that the Department has conducted a review of an otherwise illegal system and found it to be in compliance with all applicable requirements for that system. This affidavit effectively removes the illegal installation status on this system.

DISCLAIMER

This affidavit of review is not a guarantee by the Department that the system will continue to function properly for any prescribed period of time.

Assessment Code _____

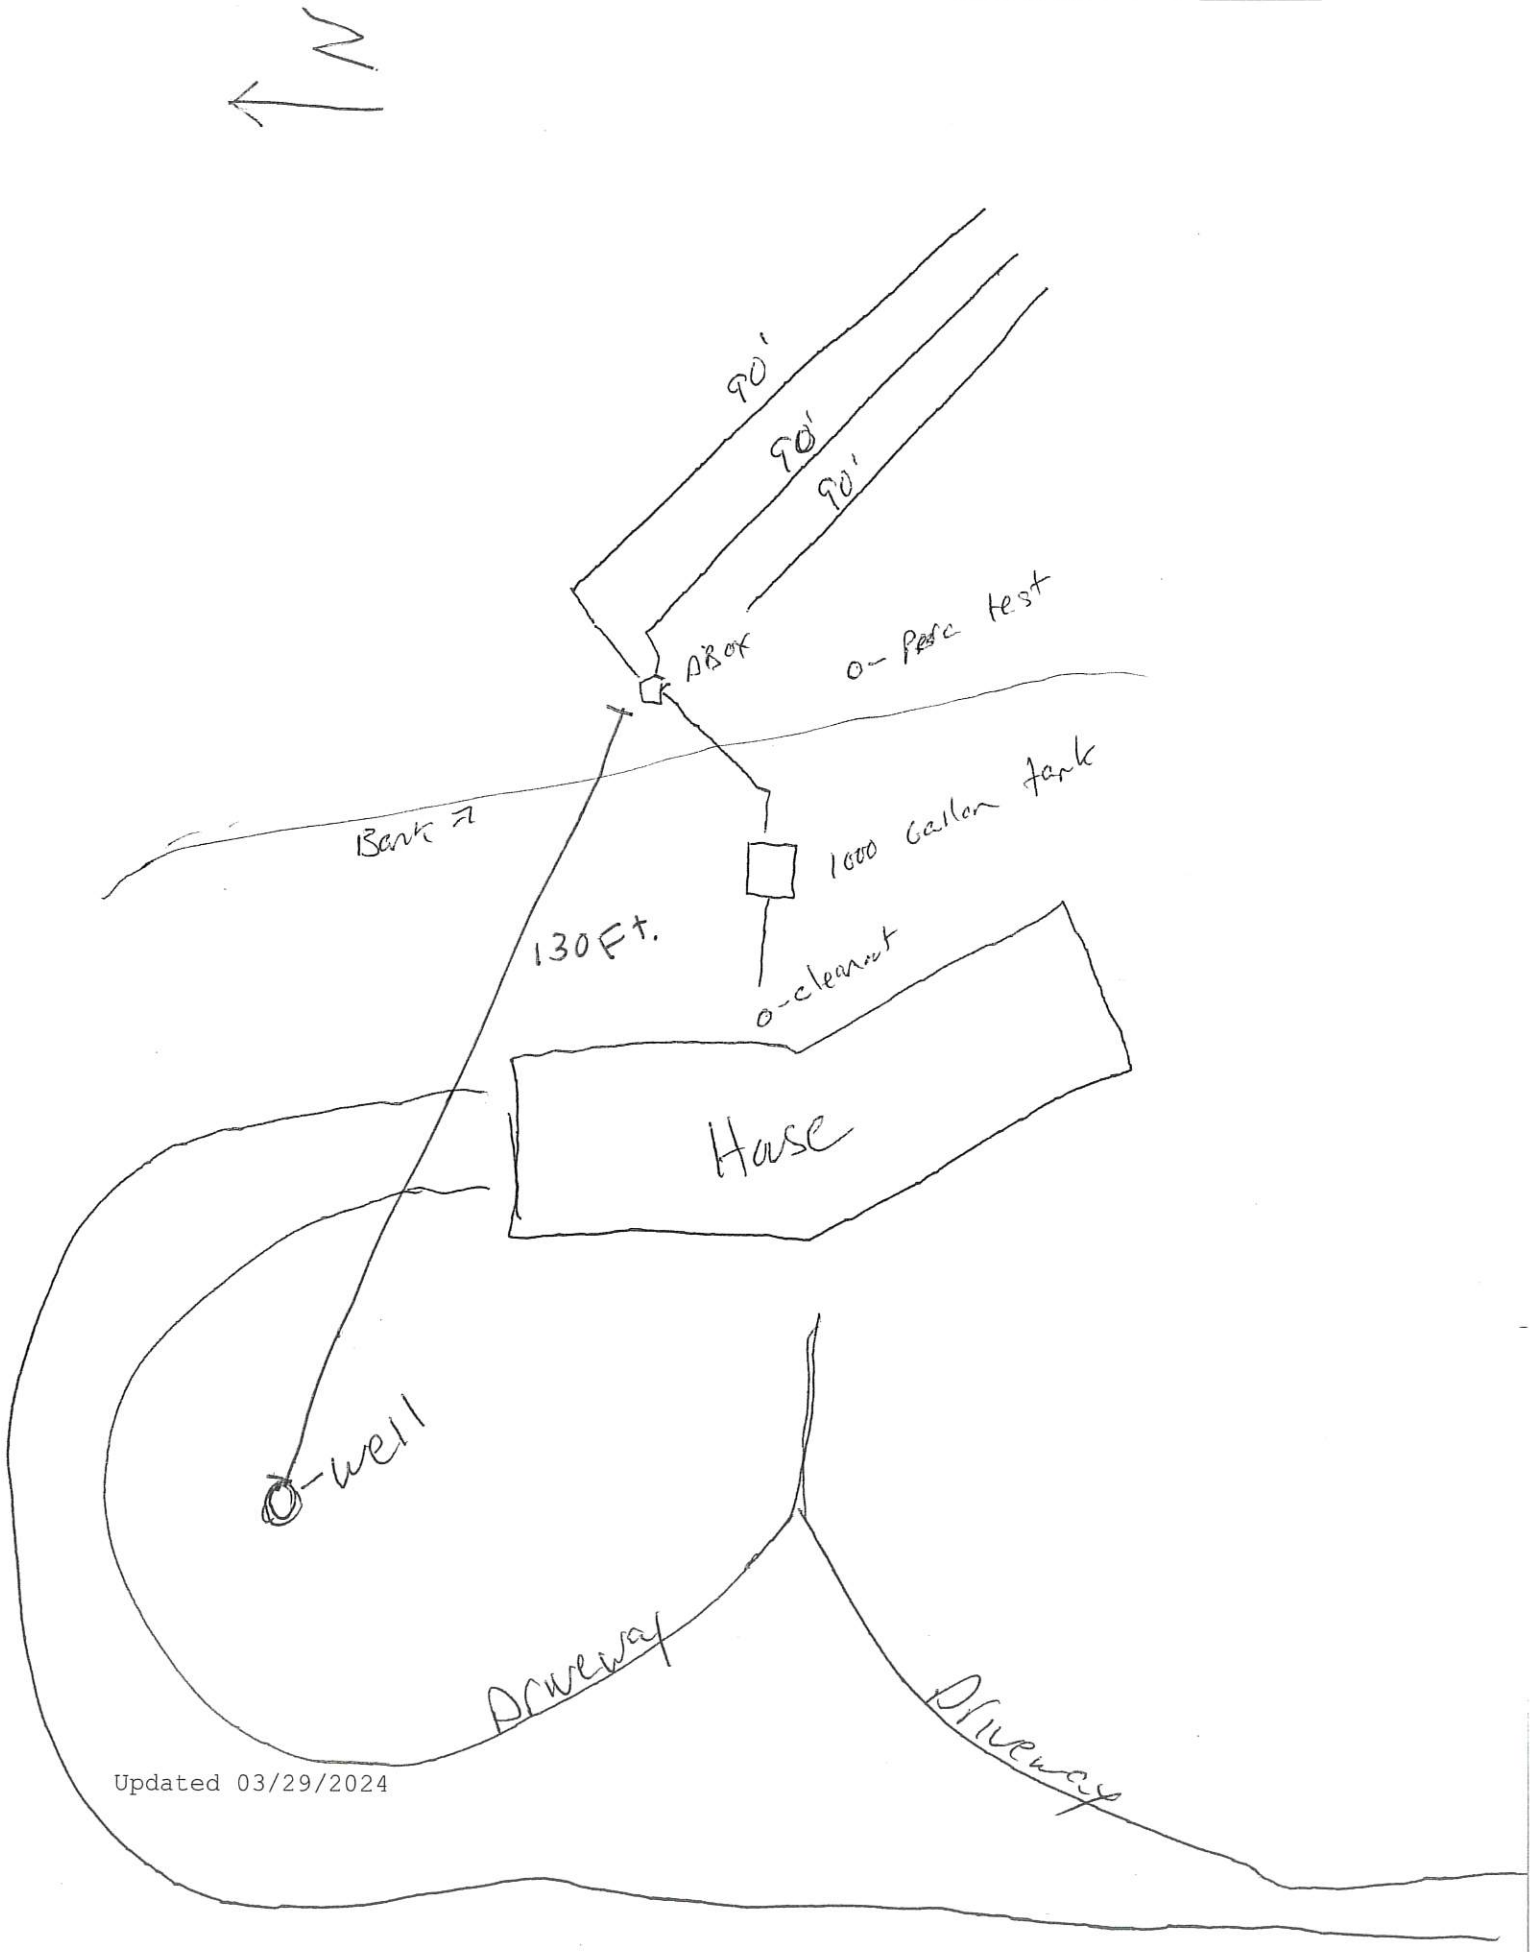

Updated 03/29/2024