LINCOLN COUNTY
DEPARTMENT OF ENVIRONMENTAL HEALTH Permit # 25-53056
AFFIDAVIT OF WASTEWATER TREATMENT AND DISPOSAL SYSTEM COMPLIANCE REVIEW FOR SYSTEM INSTALLED, REPAIRED OR REPLACED WITHOUT A VALID PERMIT

Issue Date: 01/27/2025

2026

Property Owner: Robert White

Mailing Address: [redacted]

Name of Person Who Installed System Being Reviewed: John Beyers License #

Type of System Work Reviewed:

x New Installation ____ Existing System

____ Repair ____ Replacement ____ Extension ____ Other

Describe: New installation of gravity system for 2 Bedroom House with 2 laterals @ 75'.

Property Description:

Legal: S36, T34 N, R25 W, ACRES 38.02, N2NW BETWEEN BN R/WS

Address or Location: 293 Sunday Creek, Stryker, MT 59933

Reviewed Design Components: Ken Davis

Septic Tank: 1000 Gallon Effluent Filter: Yes

Dosing or Lift Tank: No Drainfield Size: 2 Laterals @75' Trench Depth: 36" Trench Width: 36"

Assessment code: 53056

Comments: System was installed on 4/15/2011 by the homeowner and John Beyers without a permit. The laterals and tank were exposed by Ken Davis 08/03/2024.

System Review Documentation Statement:

I, Robin Blumberg, have reviewed the components of this system as listed above and found it to be in compliance with the sizing, construction, orientation and operating requirements of Chapter 17, Subchapter 9 A.R.M., Circular DEQ-4 and Lincoln County Wastewater Regulation #3.

Signed: Robin Blumberg *Date:* 1/27/25

Title: R.S.

NOTICE: This document is not a permit for installation, repair or alterations of a wastewater treatment system. It is merely a statement of affirmation that the Department has conducted a review of an otherwise illegal system and found it to be in compliance with all applicable requirements for that system. This affidavit effectively removes the illegal installation status on this system.

DISCLAIMER

This affidavit of review is not a guarantee by the Department that the system will continue to function properly for any prescribed period of time.

SV

LINCOLN COUNTY MONTANA


LOT LAYOUT: SUNDAY CREEK RANCH LOT 1:

BOOK 333 PAGE 448

In the NW 1/4 of Section 36, Twp. 34 N., R. 25 W., P.M.M.

For: Barry G. Stidham & Robert T. White

Date: May 2024

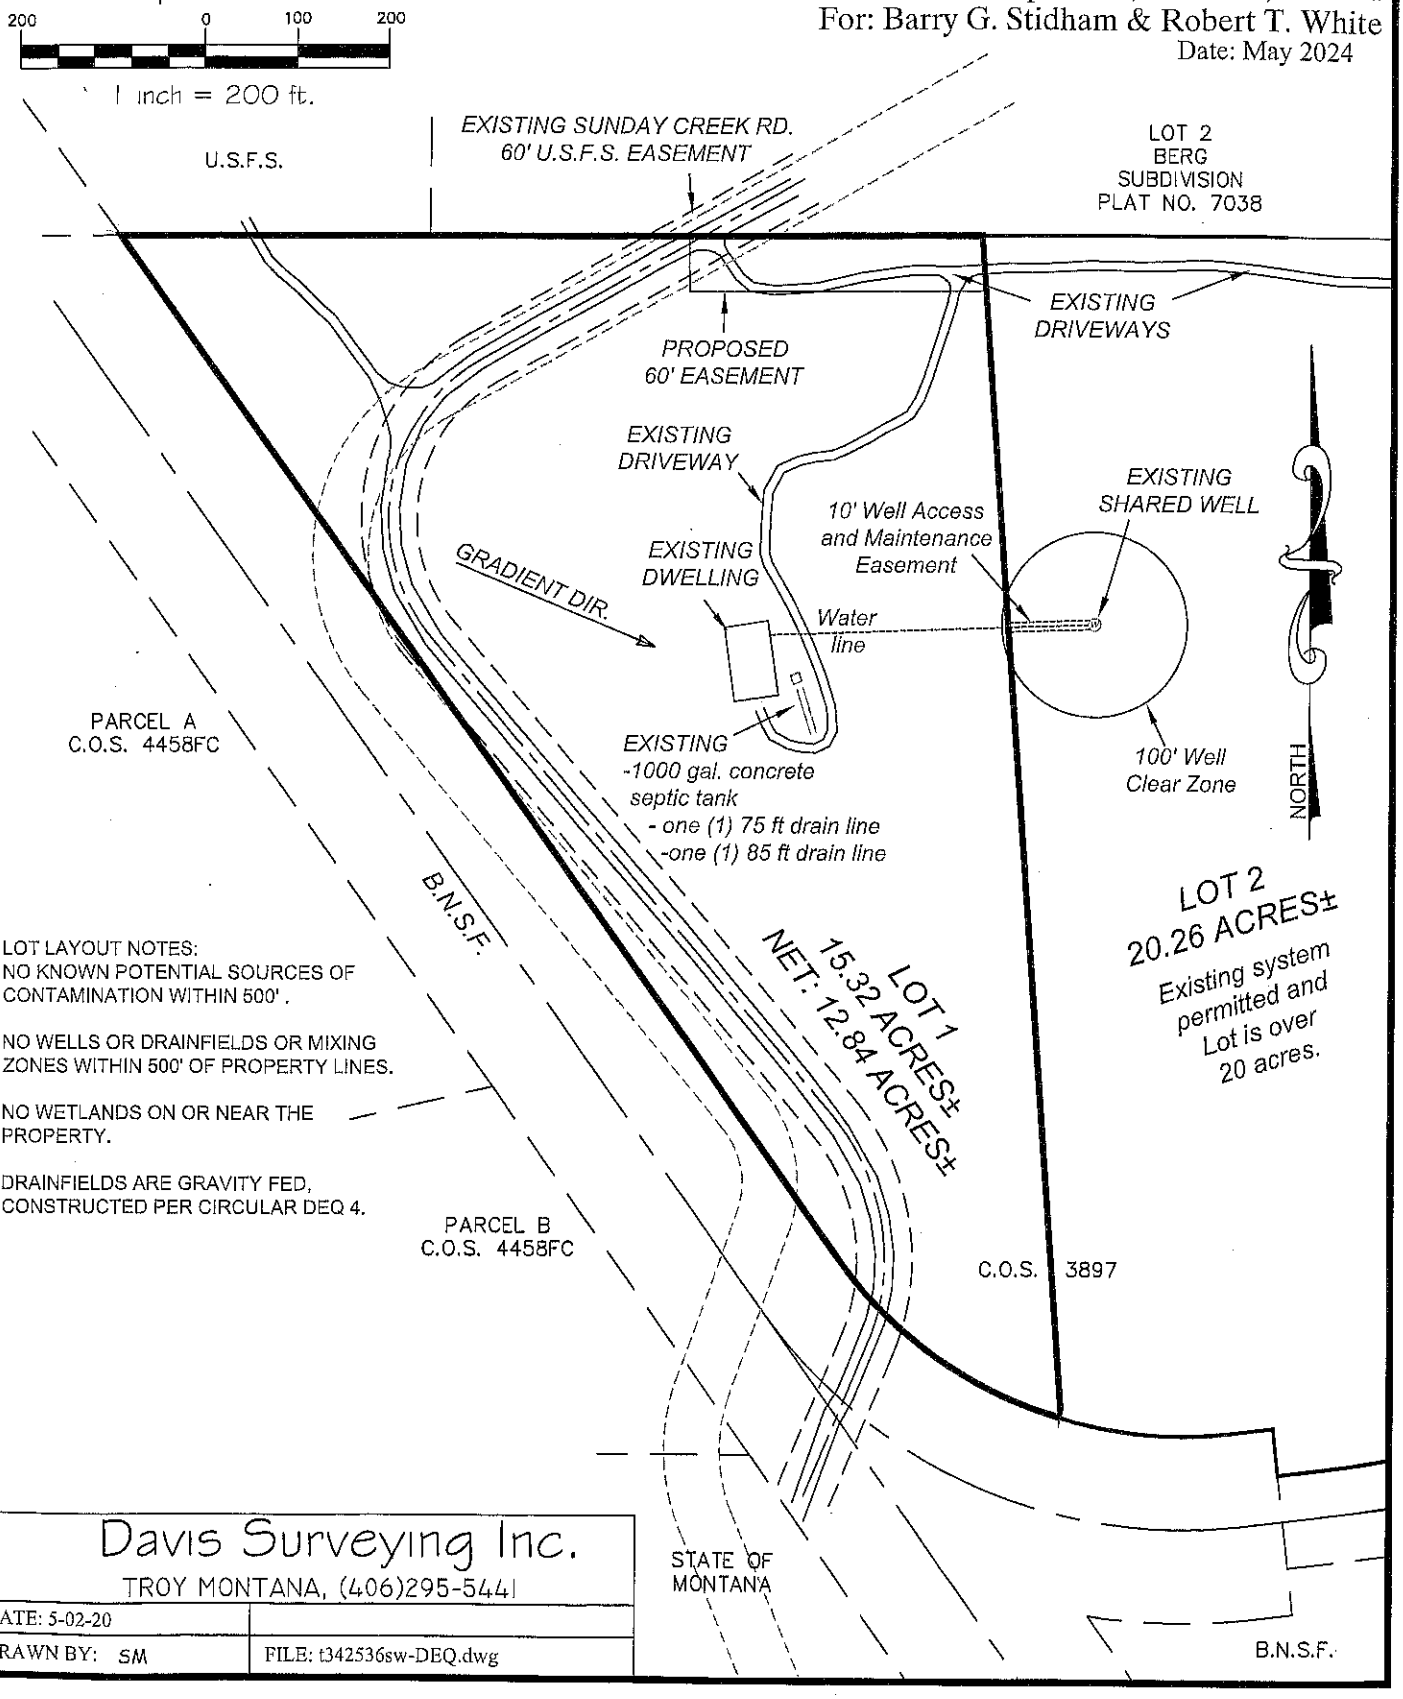

LOT LAYOUT NOTES:
NO KNOWN POTENTIAL SOURCES OF CONTAMINATION WITHIN 500'.

NO WELLS OR DRAINFIELDS OR MIXING ZONES WITHIN 500' OF PROPERTY LINES.

NO WETLANDS ON OR NEAR THE PROPERTY.

DRAINFIELDS ARE GRAVITY FED, CONSTRUCTED PER CIRCULAR DEQ 4.

Davis Surveying Inc.
TROY MONTANA, (406)295-5441

DATE: 5-02-20	
DRAWN BY: SM	FILE: t342536sw-DEQ.dwg