LINCOLN COUNTY HEALTH DEPARTMENT
ENVIRONMENTAL HEALTH
WASTEWATER TREATMENT AND DISPOSAL SYSTEM PERMIT

Issue Date: 7/26/2022 Expiration Date: 7/25/2023

Property Owner: Charles Nelson

Mailing Address: [redacted]

Telephone: Email:

Installer: Riley Excavating License #: 147

Proposed Work: (Check One) ☐ New Installation ☒ Existing System

☒ Replace Drainfield ☐ Replace Tank ☐ Extension

Describe: Standard trenches, gravity system

Parcel Description:

Legal: Pinewood Village, Blk 9, Lot 2, S25 T30N R31W, 0.23 acres

Property Address: 316 Tamarack Ln, Libby Assessment Code: 9204

Approved Design Criteria:

# of Bedrooms: 2 Septic Tank Size: 1000 gallons Drainfield Size: 260 square feet

# of Laterals: 2 Length of Laterals: 65 lineal feet Trench Depth: 24-36 inches

SYSTEM MUST INCLUDE INSTALLATION OF EFFLUENT FILTER AT SEPTIC TANK OUTLET!!

Special Instructions: Install system according to the COSA, lot layout, the Lincoln County Wastewater Treatment and Disposal Regulation, and Circular DEQ-4. ANY CHANGES MUST BE PRE-AUTHORIZED BY THE DEPARTMENT.

Issued By: *Kathi J. Hooper, R.S.*

NOTICE: The Department must be notified at least 3 business days (72 hours) prior to backfilling the system. Call 406-283-2442. Any system not inspected by the Department or its designated representative prior to closure is an illegal installation in violation of Lincoln County Health Board Regulation Ch. 3. Illegal installations may result in fines and/or requirements to remove or reconstruct the system.

Closure Statement:

This system is in compliance with the approved design criteria Lincoln County's Wastewater Treatment and Disposal Regulation and the variance to ARM 17.36.918 approved by the City-County Board of Health for Lincoln County on 05/09/2023.

Signed: [signature] *Date:* 5/9/2023


/ Lincoln County Health Department (LCHD) ____ Licensed Installer w/ approval of LCHD

DISCLAIMER

This permit is not a guarantee by the Department that the system will function properly for a prescribed period of time.

SV

As Built

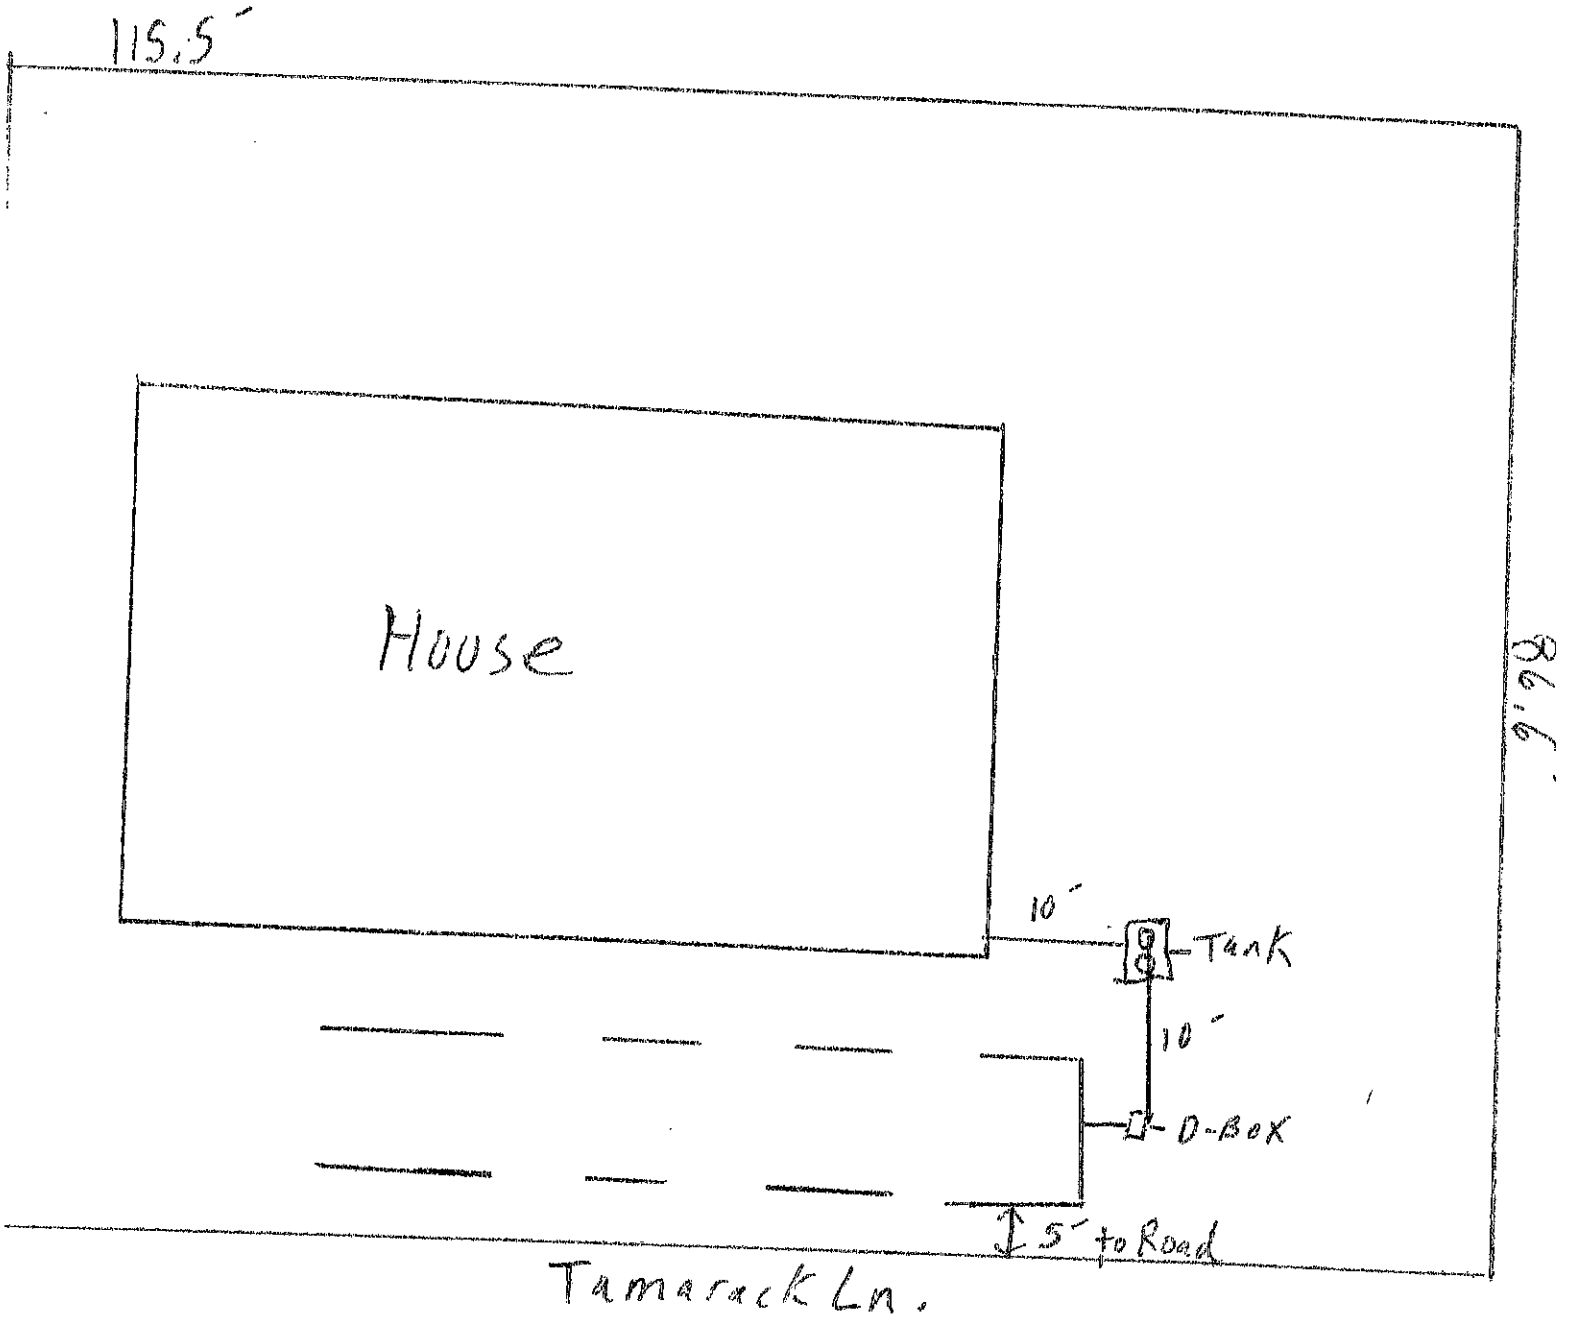

1" = 15'

N