LINCOLN COUNTY
DEPARTMENT OF ENVIRONMENTAL HEALTH #25-13086
AFFIDAVIT OF WASTEWATER TREATMENT AND DISPOSAL SYSTEM COMPLIANCE REVIEW FOR SYSTEM INSTALLED, REPAIRED OR REPLACED WITHOUT A VALID PERMIT

Issue Date: 04/30/2025

Property Owner: Jude and Lisa Spors-Murphy

Mailing Address: [redacted]

Name of Person Who Installed System Being Reviewed: Jay Sandlin License #

Type of System Work Reviewed:

_x_ New Installation ____ Existing System

____ Repair ____ Replacement ____ Extension ____ Other

Describe: New installation of gravity system for 2 Bedroom House with 4 laterals @ 75'.

Property Description:

Legal: S24, T35 N, R26 W, COS 3158, PARCEL A, ACRES 40.12, OR SWNW 13086

Address or Location: 144 Mill Site Drive Eureka, MT 59917

Reviewed Design Components: Mont Peters Rocky Mountain Radar

Septic Tank: 1000 Gallon Effluent Filter: Yes

Dosing or Lift Tank: No Drainfield Size: 4 Laterals @75' Trench Depth: 18-24" Trench Width: 36"

Assessment code: 13086

Comments: System was installed by Jay Sandlin who was not licensed at the time the installation began but became licensed after several months. Conflict with the homeowners and the installer about the licensing and fees continued and a permit was not obtained.

System Review Documentation Statement:

I, Robin Blumberg, have reviewed the components of this system as listed above and found it to be in compliance with the sizing, construction, orientation and operating requirements of Chapter 17, Subchapter 9 A.R.M., Circular DEQ-4 and Lincoln County Wastewater Regulation #3.

Signed: Robin Blumberg *Date:* 4/30/25


Title: R.S.

NOTICE: This document is not a permit for installation, repair or alterations of a wastewater treatment system. It is merely a statement of affirmation that the Department has conducted a review of an otherwise illegal system and found it to be in compliance with all applicable requirements for that system. This affidavit effectively removes the illegal installation status on this system.

DISCLAIMER

This affidavit of review is not a guarantee by the Department that the system will continue to function properly for any prescribed period of time.

Mont Peters
406-253-0228
Cert. GPR tech
Rocky Mountain Radar

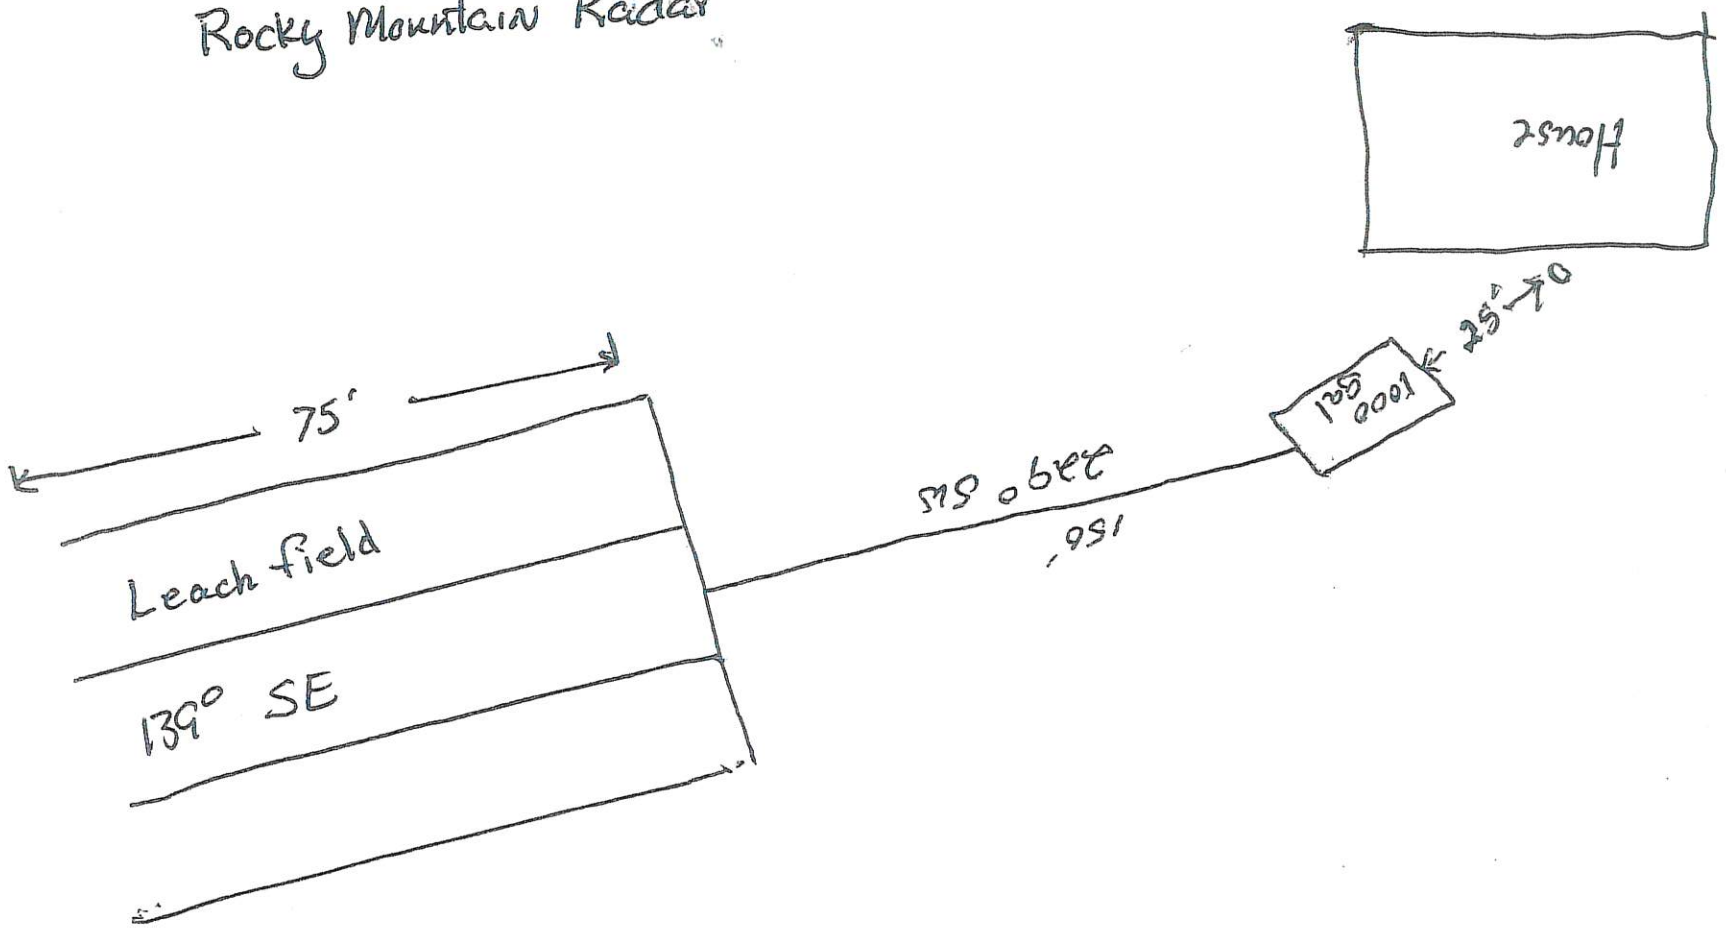

Mont Peters 8/29/24