LINCOLN COUNTY
DEPARTMENT OF ENVIRONMENTAL HEALTH
WASTEWATER TREATMENT AND DISPOSAL SYSTEM PERMIT

Issue Date: 05/13/2022 Expiration Date: 05/13/2023

Property Owner: Maria Stephenson c/o:

Address: [redacted]

Telephone: [redacted]

Installer: Dustin Welch License No. N/A

__XX__ New Installation ____ Existing System

____ Repair ____ Replacement ____ Extension ____ Other

Describe: Five laterals@ 100' chambers.

Parcel Description:

Legal: TEMPLIN, S24, T31 N, R34 W, ACRES 20.87, LOT 1 in NE PM 6654

Address or Location: LOT 1

Geo/Assessors code: 0000013231

Approved Design Criteria:

Bedrooms: 5 Septic Tank Size: 1500 gallons Drainfield Size: 500 Lineal Feet

SYSTEM MUST INCLUDE INSTALLATION OF EFFLUENT FILTER AT SEPTIC TANK OUTLET !!

Special Instructions: INSTALL SYSTEM ACCORDING TO LAYOUT, DEQ-4 AND LINCOLN COUNTY WASTEWATER REGULATION #3. ANY DEVIATIONS FROM APPROVED PLAN MUST BE AUTHORIZED BY THE DEPARTMENT. **Exact configuration/layout of tanks unknown at time of permitting. Applicant to provide revised layout and/or as-built once determined.**

Issued By: Nicholas Raines

Closure Statement:

I, Robin Blumberg, *have inspected this system and found it to be in compliance with the conditions of the permit, and the Lincoln County Wastewater Treatment and Disposal Regulation.*

Signed: Robin Blumberg *Date:* 5/9/23

Title: SIT


NOTICE: The Department must be notified at least 48 business hours prior to backfilling the system. Any system not inspected by the Department or its designated representative prior to closure is an illegal installation in violation of Lincoln County Health Board Regulation No. 3. Illegal installations may result in fines and/or requirements to remove or reconstruct the system.
406-283-2442

DISCLAIMER

This permit is not a guarantee by the Department that the system will function properly for a prescribed period of time.

S

Stephenson
322 Templin Dr, Troy

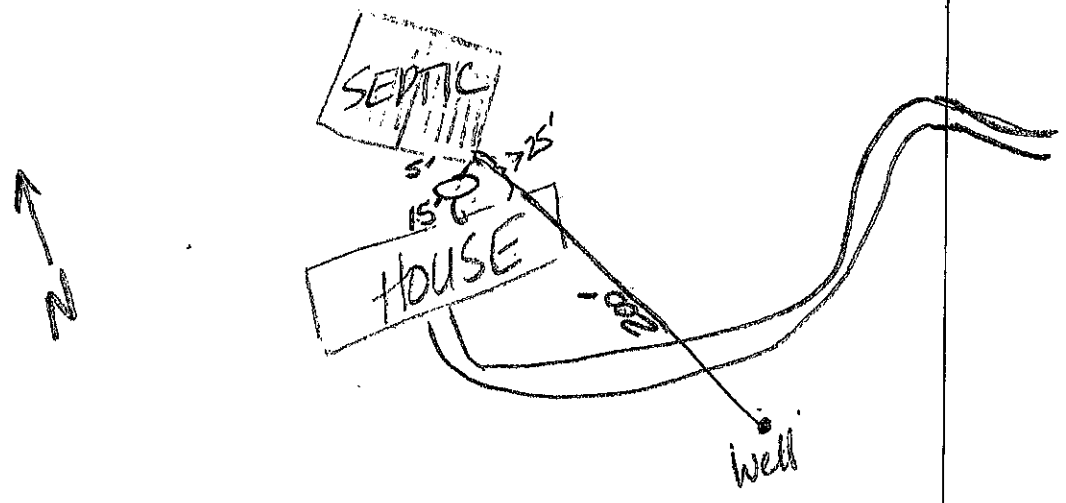

5 bedroom house