LINCOLN COUNTY
DEPARTMENT OF ENVIRONMENTAL HEALTH
WASTEWATER TREATMENT AND DISPOSAL SYSTEM PERMIT

Issue Date: 03/17/08 Expiration Date: 03/18/09

Property Owner: Tobacco Valley Construction c/o: Koocanusa Excavating, Inc.

Address: [redacted]

Telephone: (Home) (Work) [redacted]

Installer: Koocanusa Excavating, inc. License No. 135

XX New Installation _____ Existing System

_____ Repair _____ Replacement _____ Extension _____ Other

Describe: Installing three 85-foot trenches – provide as-built drawing on completion

Parcel Description:

Legal: Lot 5 of Ravens Ridge Subdivision

Address or Location: 170 Redwing Drive

Approved Design Criteria:

Bedrooms 3 Septic Tank Size: 1000 gallons Drainfield Size: 255 Linear Feet

SYSTEM MUST INCLUDE INSTALLATION OF EFFLUENT FILTER AT SEPTIC TANK OUTLET !!

Special Instructions: INSTALL SYSTEM ACCORDING TO LAYOUT, DEQ-4 AND LINCOLN COUNTY WASTEWATER REGULATION #3. ANY DEVIATIONS FROM APPROVED PLAN MUST BE AUTHORIZED BY THE DEPARTMENT.

Issued By: *Kendra J. Lind, R.S.*

Closure Statement:

I, _____, have inspected this system and found it to be in compliance with the conditions of the permit, and the Lincoln County Wastewater Treatment and Disposal Regulation.

Signed: _____ *Date:* _____

Title: _____

NOTICE: The Department must be notified at least 48 hours prior to backfilling the system. Any system not inspected by the Department or its designated representative prior to closure is an illegal installation in violation of Lincoln County Health Board Regulation No. 3. Illegal installations may result in fines and/or requirements to remove or reconstruct the system.

406-293-7781


DISCLAIMER

This permit is not a guarantee by the Department that the system will function properly for a prescribed period of time.

ATTN: Buck lot 5

Legend
- O perctest
- □ testhole
- drainfield site
- replacement area
- wellsite w/100' isolation
- mixing zone
- proposed driveway w/Roadside Swale (see detail)
- XXXXXXX- SCD (see detail)

Address:
170 Redwing Dr

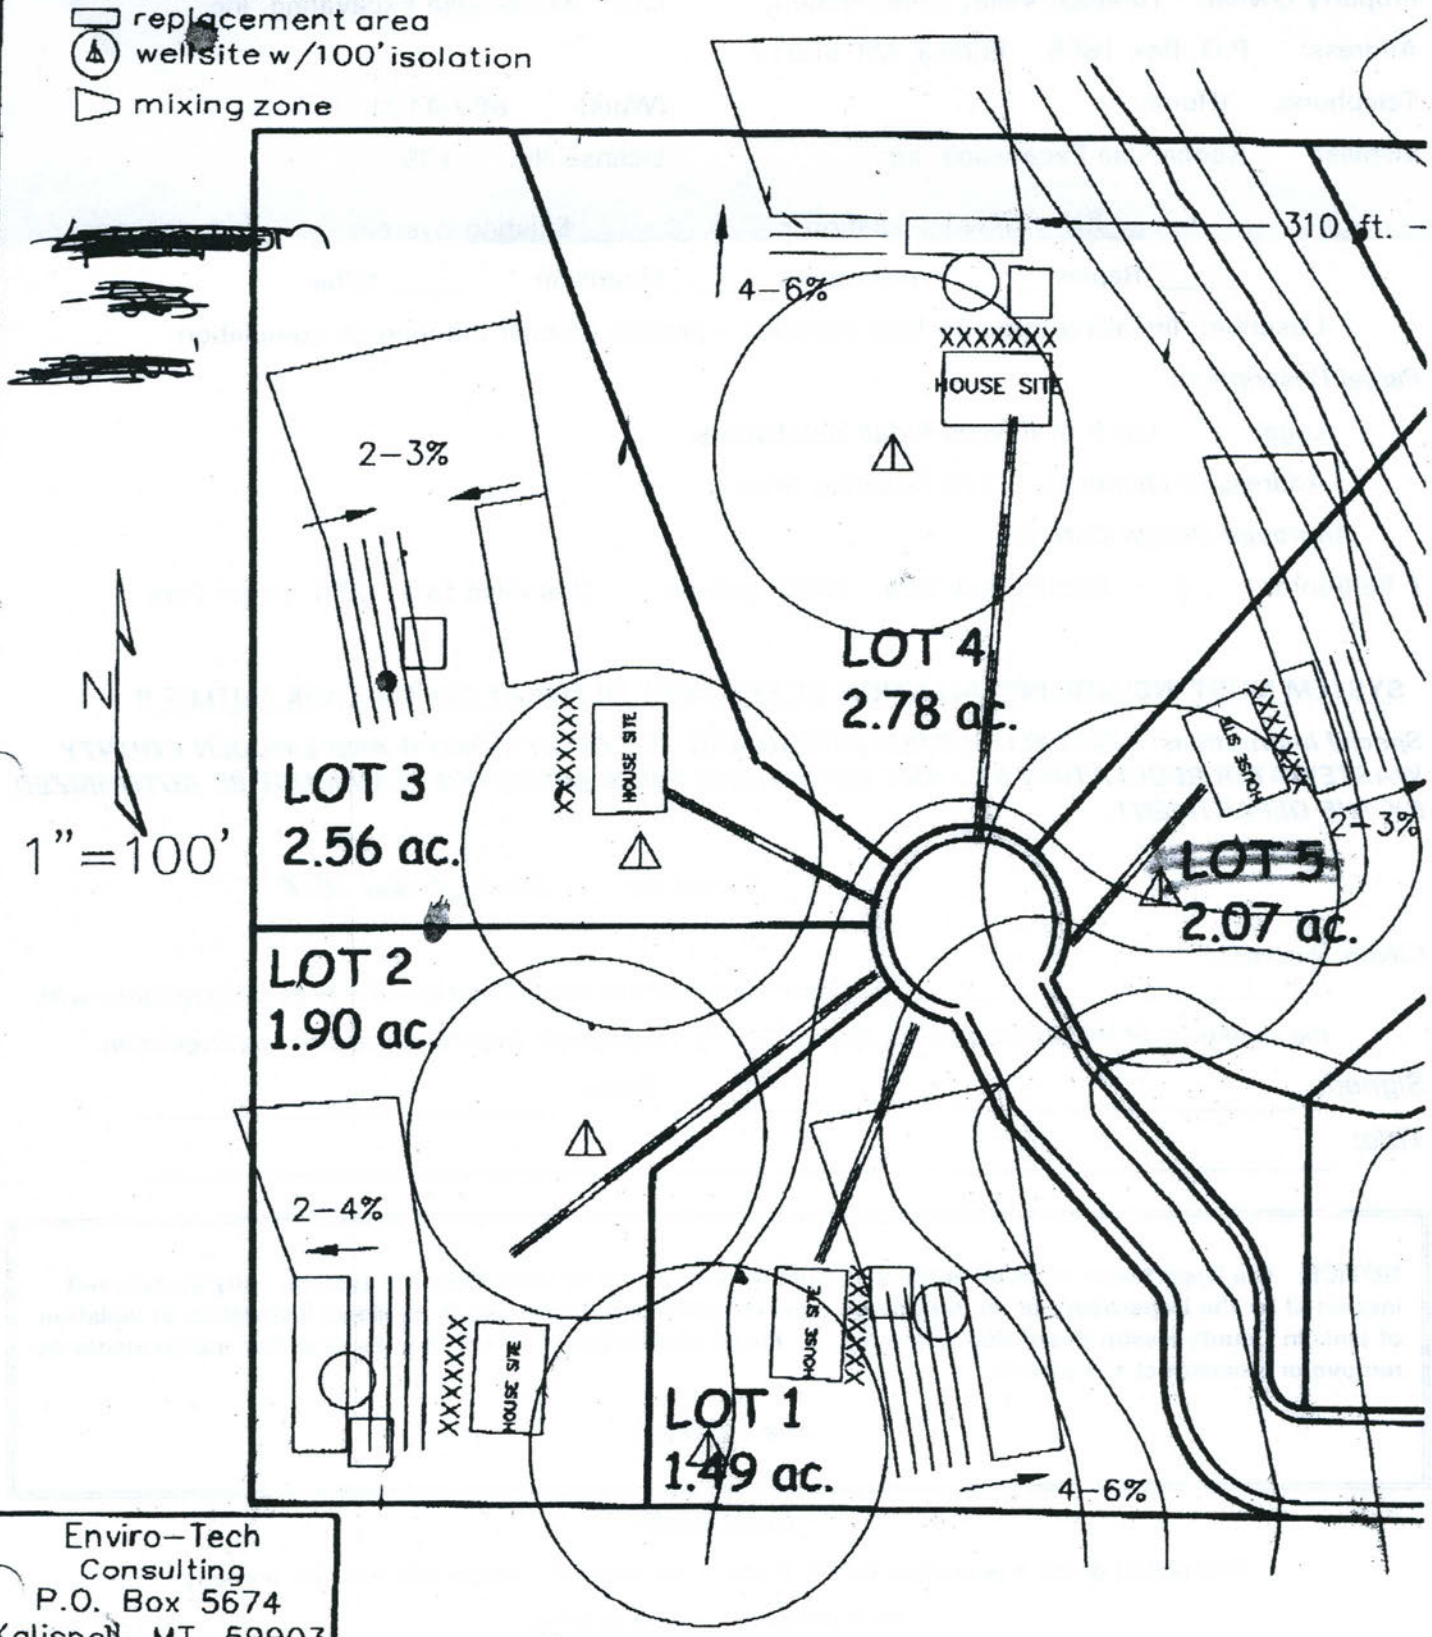

Enviro-Tech
Consulting
P.O. Box 5674
Kalispell, MT. 59903
~~(406) 261-7365~~
251-2795