LINCOLN COUNTY
DEPARTMENT OF ENVIRONMENTAL HEALTH
AFFIDAVIT OF WASTEWATER TREATMENT AND DISPOSAL SYSTEM COMPLIANCE REVIEW FOR SYSTEM INSTALLED, REPAIRED OR REPLACED WITHOUT A VALID PERMIT

Issue Date: 04/11/2025 Doc.#25-56382

Property Owner: Simon and Denise Troyer

Mailing Address: [redacted]

Name of Person Who Installed System Being Reviewed: Billie Gardner License # 177

Type of System Work Reviewed:

_x_ New Installation ____ Existing System

____ Repair ____ Replacement ____ Extension ____ Other

Describe: New installation of gravity system for 3 Bedroom House with 3 laterals @ 85'.

Property Description:

Legal: VALHALLA ESTATES, S12, T29 N, R31 W, ACRES 30.985, PM 7198 LOT 2

Address or Location: 40161 US HWY 2 Libby, MT 59923

Reviewed Design Components: Billie Gardner

Septic Tank: 1000 Gallon Effluent Filter: Yes

Dosing or Lift Tank: No Drainfield Size: 3 Laterals @85' Trench Depth: 36" Trench Width: 36"

Assessment code: 56382

Comments: System was installed 08/2021. Reviewed details with sanitarian and was given design requirements, but system was installed without permit at the time of his tragic demise.

System Review Documentation Statement:

I, Robin Blumberg, have reviewed the components of this system as listed above and found it to be in compliance with the sizing, construction, orientation and operating requirements of Chapter 17, Subchapter 9 A.R.M., Circular DEQ-4 and Lincoln County Wastewater Regulation #3.

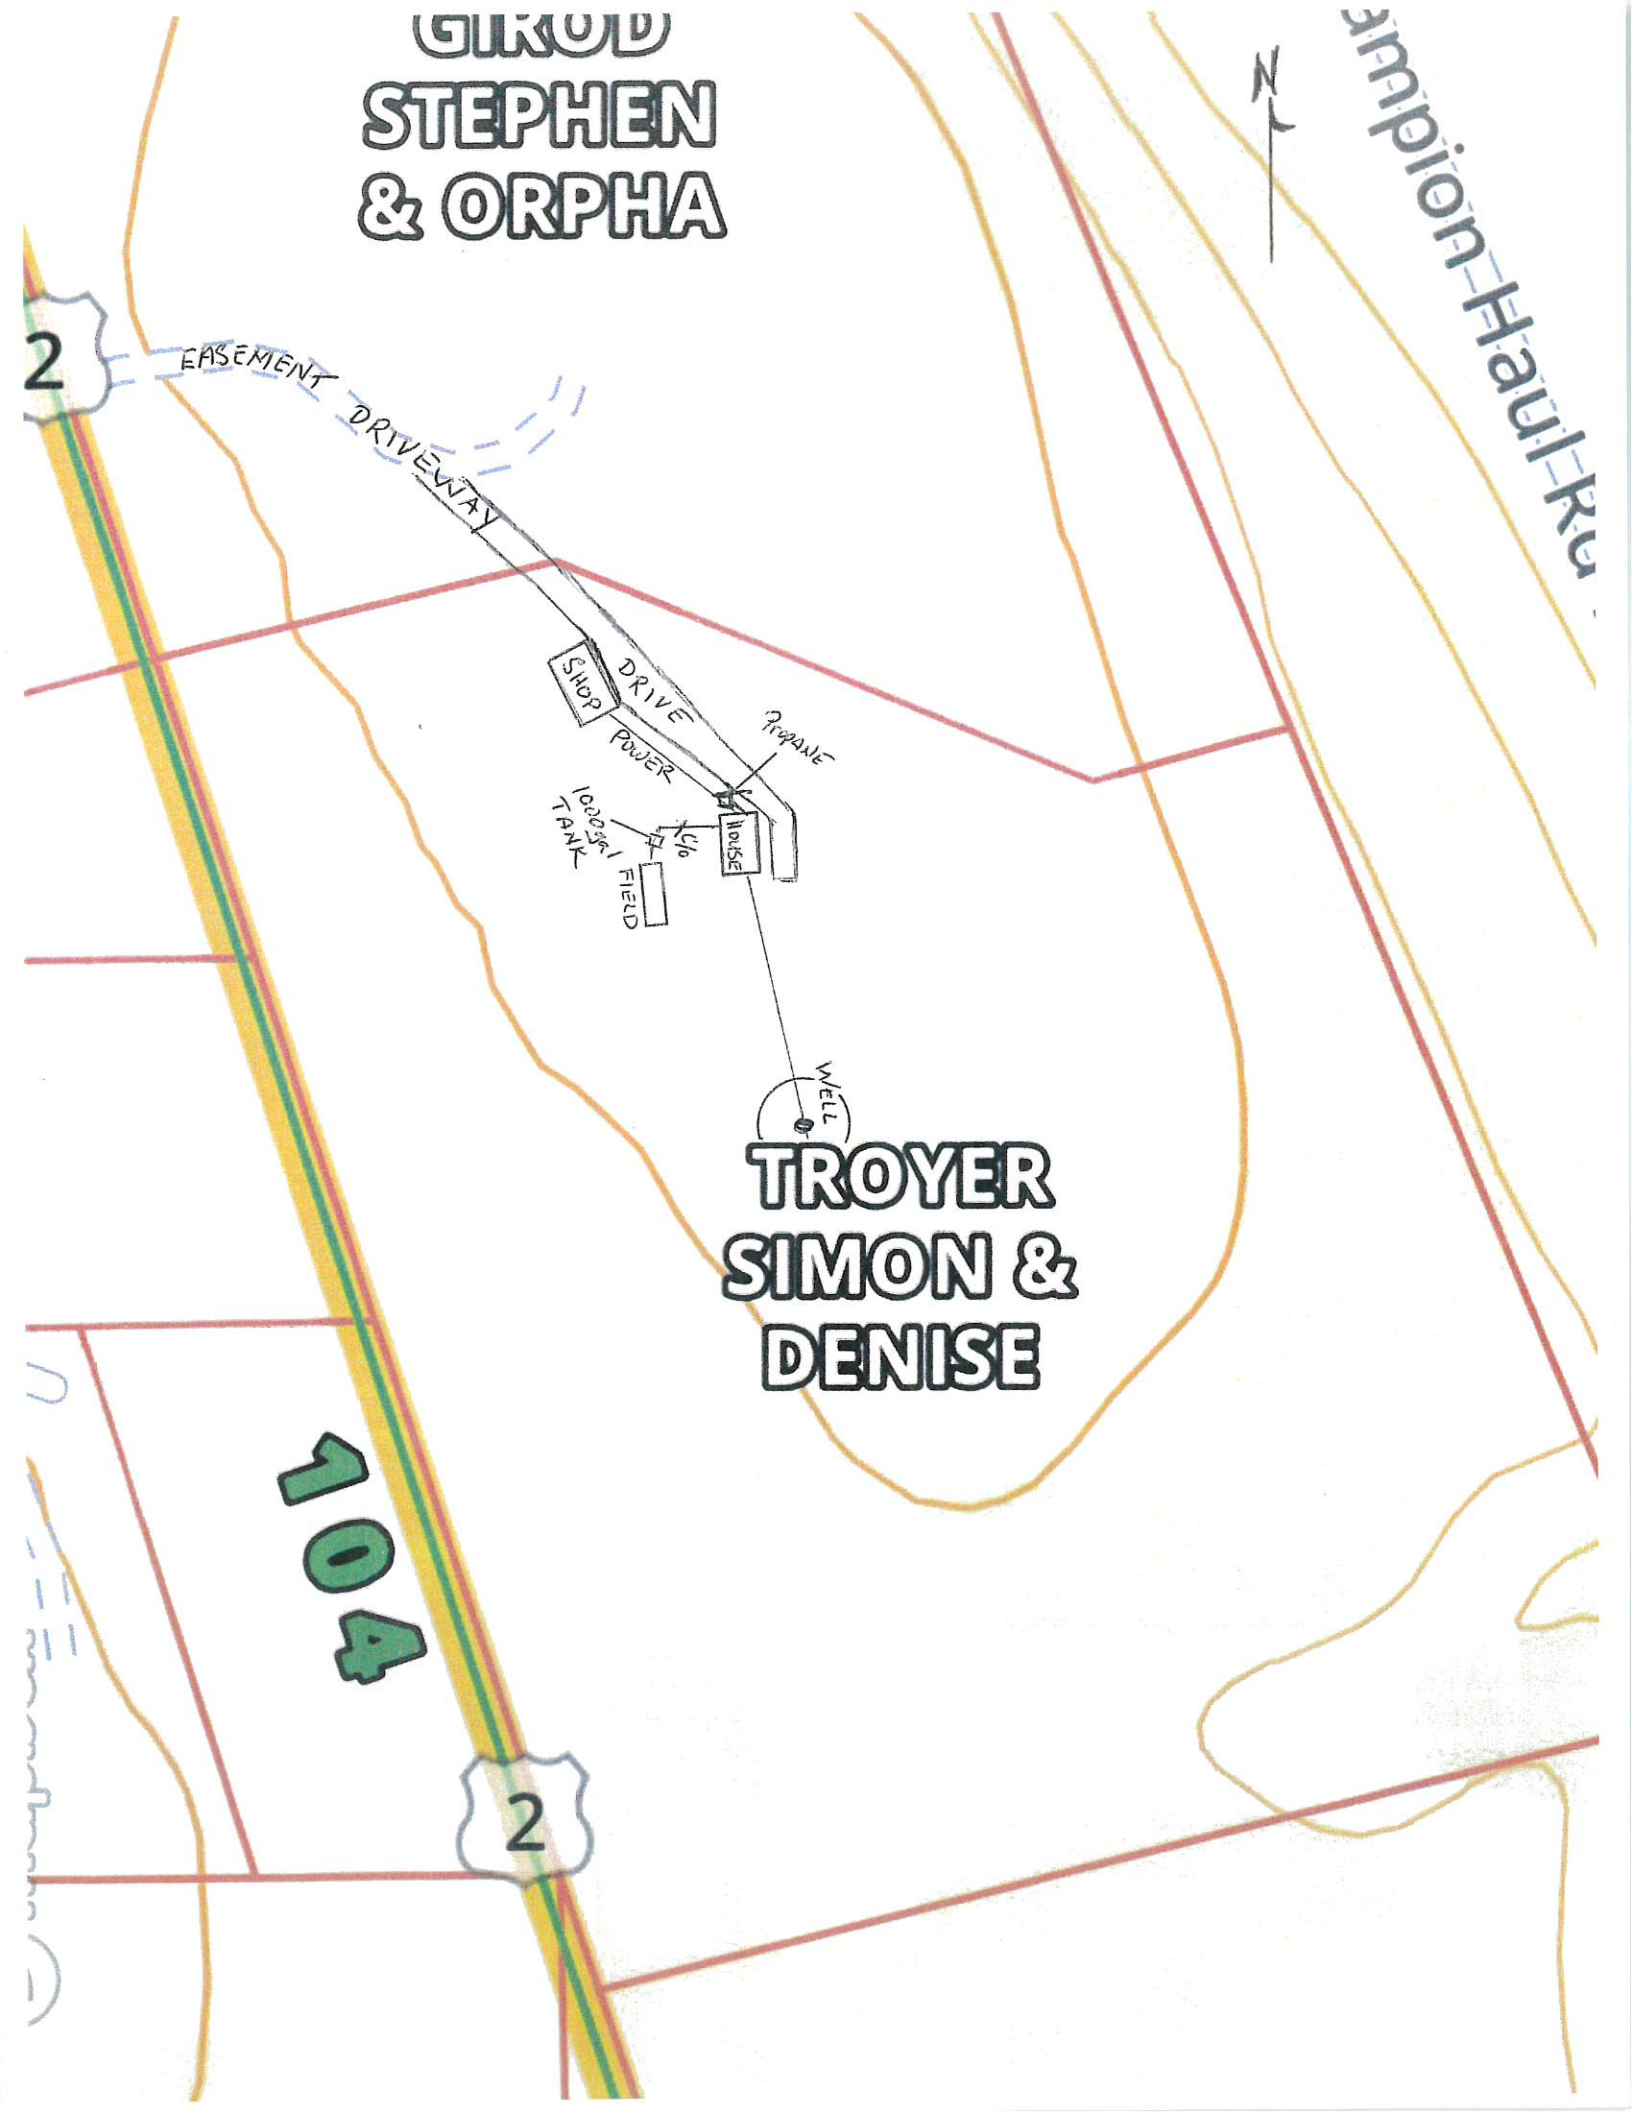
Signed: Robin Blumberg *Date:* 4/11/25

Title: R.S.

NOTICE: This document is not a permit for installation, repair or alterations of a wastewater treatment system. It is merely a statement of affirmation that the Department has conducted a review of an otherwise illegal system and found it to be in compliance with all applicable requirements for that system. This affidavit effectively removes the illegal installation status on this system.

DISCLAIMER

This affidavit of review is not a guarantee by the Department that the system will continue to function properly for any prescribed period of time.


GIROD
STEPHEN
& ORPHA
2
EASEMENT DRIVEWAY
SHOP
DRIVE
POWER
PROPANE
1000 GAL TANK
X/G
FIELD
HOUSE
WELL
TROYER
SIMON &
DENISE
104
2
N