LINCOLN COUNTY HEALTH DEPARTMENT
ENVIRONMENTAL HEALTH
WASTEWATER TREATMENT AND DISPOSAL SYSTEM PERMIT

Permit # 23-14350

Issue Date: 06/07/2023 Expiration Date: 06/06/2024

Property Owner: Tim and Kathy Warner

Mailing Address: [redacted]

Telephone: E-mail:

Installer: Franklin Fifield License #: 198

Approved Work: (Check One) ☒ New Installation ☐ Existing System

☐ Replace Drainfield ☐ Replace Tank ☐ Extension

Describe: Installation of gravity system.

Parcel Description:

Legal: S20, T29 N, R33 W, C.O.S. 3996, PARCEL D, ACRES 28.626

Property Address: Assessment Code: 14350

DEQ COSA: Date:

Approved Design Criteria; Installation of new gravity system with 4 laterals @ 96'.

# of Bedrooms: 2 Septic Tank Size: 1000 gallons Trench Width: 24"

# of Laterals: 4 Length of Laterals: 96' Trench Depth: 24"-36"

SYSTEM MUST INCLUDE INSTALLATION OF EFFLUENT FILTER AT SEPTIC TANK OUTLET!!

Special Instructions: Install system according to the COSA, lot layout, the Lincoln County Wastewater Treatment and Disposal Regulation, and Circular DEQ-4. It is the installer's responsibility to ensure that all required horizontal setbacks are met. CHANGES MUST BE PRE-AUTHORIZED BY THE DEPARTMENT.

Issued By: Robin Blumberg, SIT

NOTICE: The Department must be notified at least 3 business days (72 hours) prior to backfilling the system. Call 406-283-2442. Any system not inspected by the Department or its designated representative prior to closure is an illegal installation in violation of Lincoln County Health Board Regulation Ch. 3. Illegal installations may result in fines and/or requirements to remove or reconstruct the system.

Closure Statement:

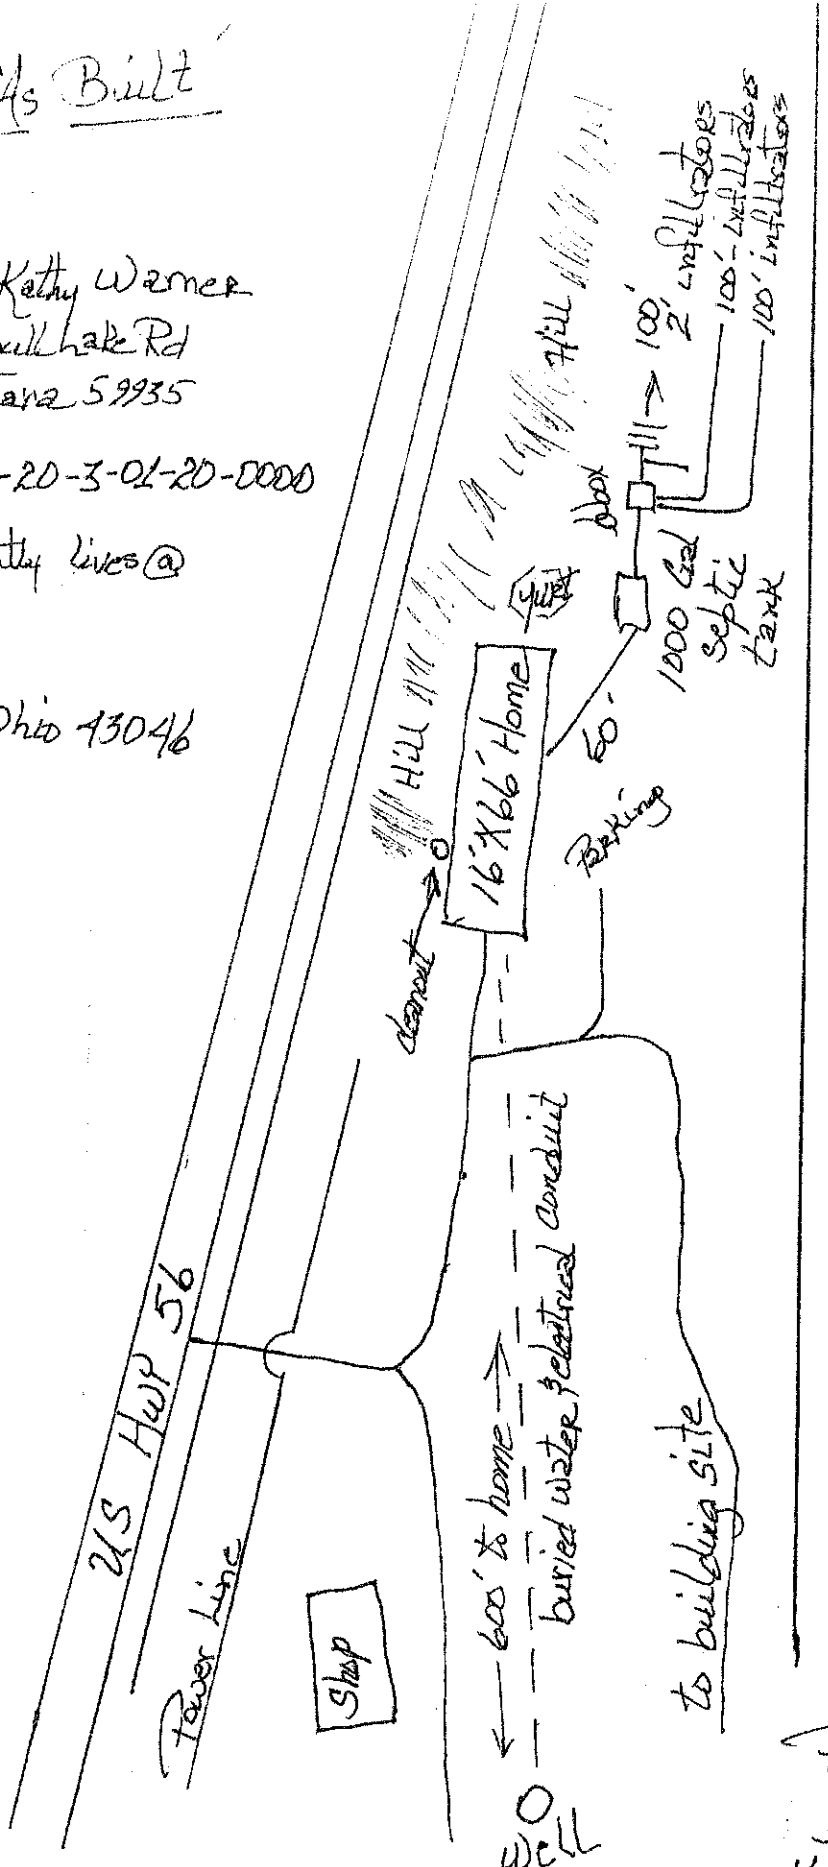
This system is in compliance with the approved design criteria and Lincoln County's Wastewater Treatment and Disposal Regulation.

Signed: Robin Blumberg *Date:* 4/25/24

_____ Lincoln County Health Department (LCHD) _____ Licensed Installer w/ approval of LCHD

DISCLAIMER

This permit is not a guarantee by the Department that the system will function properly for a prescribed period of time.


N
As Built
Owner: Timothy & Kathy Warner
20778 Bull Lake Rd
Troy, Montana 59935
Geocode: 56-4064-20-3-01-20-0000
Note: Owner currently lives @
Tim Warner
9740 Lake Rd
Millersport, Ohio 43046
US Hwy 56
Power Line
Shop
600' to home
buried water & electrical conduit
WELL
to building site
Hill
16'X66' Home
Parking
60'
Septic
1000 Gal
Septic Tank
Box
Hill -> 100'
Prepared by:
Franklin Fifield
Keeler Cr. Const. LLC
May 9, 2024