LINCOLN COUNTY
DEPARTMENT OF ENVIRONMENTAL HEALTH
WASTEWATER TREATMENT AND DISPOSAL SYSTEM PERMIT

Issue Date: 04/08/2022 Expiration Date: 04/08/2023

Property Owner: Dresselhaus, Ann c/o:

Address: [redacted]

Telephone: [redacted]

Installer: Nelson Excavating License No. 118

__XX__ New Installation ____ Existing System

____ Repair ____ Replacement ____ Extension ____ Other

Describe: 1,000-gallon septic tank with effluent filter. Gravity feed system with graveless trenches (infiltrators). 3 laterals at 85-feet in length each.

Parcel Description:

Legal: MONTANA LAKES, S24, T27 N, R28 W, Lot 6

Address or Location: 3733 ACM Rd Libby, MT 59923

Geo/Assessors code: 0000050537

Approved Design Criteria:

Bedrooms: 2 Septic Tank Size: 1,000 gallon Drainfield Size: 255 Linear Feet

SYSTEM MUST INCLUDE INSTALLATION OF EFFLUENT FILTER AT SEPTIC TANK OUTLET !!

Special Instructions: ***INSTALL SYSTEM ACCORDING TO LAYOUT, DEQ-4 AND LINCOLN COUNTY WASTEWATER REGULATION #3. ANY DEVIATIONS FROM APPROVED PLAN MUST BE AUTHORIZED BY THE DEPARTMENT.*** **INSTALLER TO PROVIDE AS-BUILT DRAIWNG DEPICTING TANK AND LINE LOCATIONS.**

Issued By: Nicholas Raines

Closure Statement:

I, SHAYNE NELSON *, have inspected this system and found it to be in compliance with the conditions of the permit, and the Lincoln County Wastewater Treatment and Disposal Regulation.*

Signed: _____ *Date:* 4/18/2022

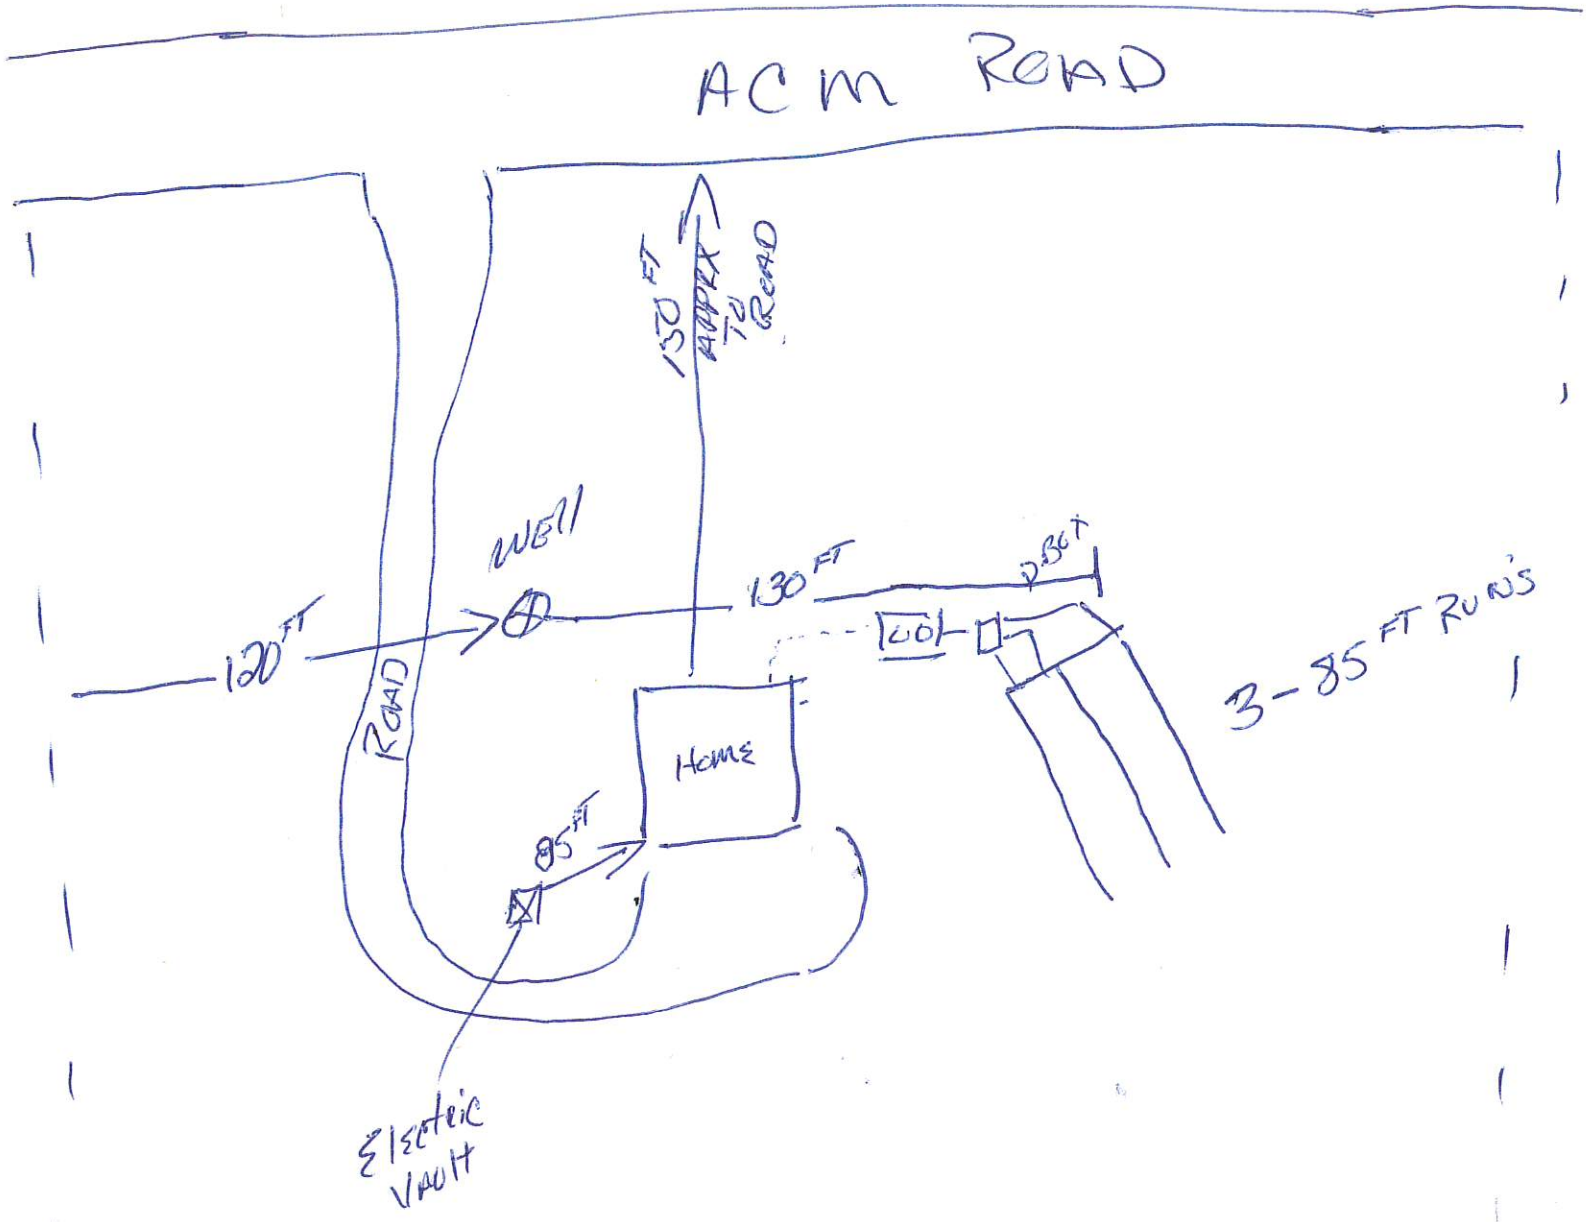
Title: OWNER NELSON EX. LLC.

NOTICE: The Department must be notified at least 48 business hours prior to backfilling the system. Any system not inspected by the Department or its designated representative prior to closure is an illegal installation in violation of Lincoln County Health Board Regulation No. 3. Illegal installations may result in fines and/or requirements to remove or reconstruct the system.
406-283-2442

DISCLAIMER

This permit is not a guarantee by the Department that the system will function properly for a prescribed period of time.

MAY OUT - ON - BACK


ACM ROAD
150 FT APPROX TO ROAD
WELL
130 FT
85 FT
120 FT
ROAD
HOME
85 FT
3-85 FT RUNS
ELECTRIC VAULT