LINCOLN COUNTY HEALTH DEPARTMENT
ENVIRONMENTAL HEALTH
WASTEWATER TREATMENT AND DISPOSAL SYSTEM PERMIT

Issue Date: 7/15/2022 Expiration Date: 7/15/2023

Property Owner: Edward Frazer

Mailing Address: [redacted]

Telephone: [redacted] Email: [redacted]

Installer: Self install License #:

Proposed Work: (Check One) ☒ New Installation ☐ Existing System

☐ Replace Drainfield ☐ Replace Tank ☐ Extension

Describe: Pressure dose system with 3 laterals at 45' using 3' trenches. Location per COSA.

Parcel Description:

Legal: S09, T33 N, R34 W, ACRES 5.026, COS 921, N2SESESE

Property Address: 2044 Rocky Draw Rd, Troy, MT 59935 Assessment Code: 10414

Approved Design Criteria:

# of Bedrooms: 2 Septic Tank Size: 1000 + 500 gallons Drainfield Size: 380 ft^2

# of Laterals: 3 Length of Laterals: 42' Trench Depth: 24-36 inches

SYSTEM MUST INCLUDE INSTALLATION OF EFFLUENT FILTER AT SEPTIC TANK OUTLET!!

Special Instructions: Install system according to the COSA, lot layout, the Lincoln County Wastewater Treatment and Disposal Regulation, and Circular DEQ-4. ANY CHANGES MUST BE PRE-AUTHORIZED BY THE DEPARTMENT.

Issued By: *Jesse Haag*

NOTICE: The Department must be notified at least 3 business days (72 hours) prior to backfilling the system. Call 406-283-2442. Any system not inspected by the Department or its designated representative prior to closure is an illegal installation in violation of Lincoln County Health Board Regulation Ch. 3. Illegal installations may result in fines and/or requirements to remove or reconstruct the system.

Closure Statement:

This system is in compliance with the approved design criteria and Lincoln County's Wastewater Treatment and Disposal Regulation.


Signed: _____ *Date:* 9/1/22

X Lincoln County Health Department (LCHD) ____ Licensed Installer w/ approval of LCHD

Assessment Code 10414

AS BUILT

WELL IS OVER 50' FROM TANK - OVER 100' FROM DRAIN FIELD

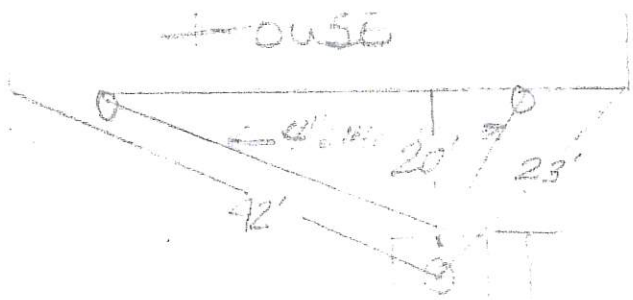

14'

PRESSURE SYSTEM SET TO 100' equiv Dose.





2" Line

70'

45'

1 1/2" Line

45'

7'

45'

Septic Tank

Pitching 3" Min

Pitching Soil Ft.

Pitching Building

NOT TO SCALE