LINCOLN COUNTY HEALTH DEPARTMENT
ENVIRONMENTAL HEALTH
WASTEWATER TREATMENT AND DISPOSAL SYSTEM PERMIT

Issue Date: 06/25/2022 Expiration Date: 06/24/2023

Property Owner: Jeff & Dhana Nelson

Mailing Address: [redacted]

Telephone: [redacted] Email:

Installer: Doug Luchini License #: 183

Proposed Work: (Check One) ☐ New Installation ☒ Existing System

☒ Replace Drainfield ☐ Replace Tank ☐ Extension

Describe: Install three 90' laterals, standard trenches, gravity flow

Parcel Description:

Legal: S10 T26 R27, Lot 1 in Stearns Subdivision

Property Address: 101 Lookout Dr, Libby Assessment Code: 2488

Approved Design Criteria:

# of Bedrooms: 3 Septic Tank Size: 1000 gallons Drainfield Size: 270 square feet

# of Laterals: 3 Length of Laterals: 90 feet Trench Depth: 24 inches

SYSTEM MUST INCLUDE INSTALLATION OF EFFLUENT FILTER AT SEPTIC TANK OUTLET!!

Special Instructions: Install system according to the lot layout, the Lincoln County Wastewater Treatment and Disposal Regulation, and Circular DEQ-4. ANY CHANGES MUST BE PRE-AUTHORIZED BY THE DEPARTMENT. Provide as-built.

Issued By: *Kathi J. Hooper, R.S.*

NOTICE: The Department must be notified at least 3 business days (72 hours) prior to backfilling the system. Call 406-283-2442. Any system not inspected by the Department or its designated representative prior to closure is an illegal installation in violation of Lincoln County Health Board Regulation Ch. 3. Illegal installations may result in fines and/or requirements to remove or reconstruct the system.

Closure Statement:

I, _____, have inspected this system and found it to be in compliance with the approved design criteria and Lincoln County's Wastewater Treatment and Disposal Regulation.

Signed: Doug Luchini *Date:* 1-24-24

____ Lincoln County Health Department (LCHD) X Licensed Installer w/ approval of LCHD


DISCLAIMER

This permit is not a guarantee by the Department that the system will function properly for a prescribed period of time.

SV

- well is on lot 2

LOT LAYOUT
JOHN & CATHERINE STEARNS
LOT #1
STEARNS SUBDIVSION

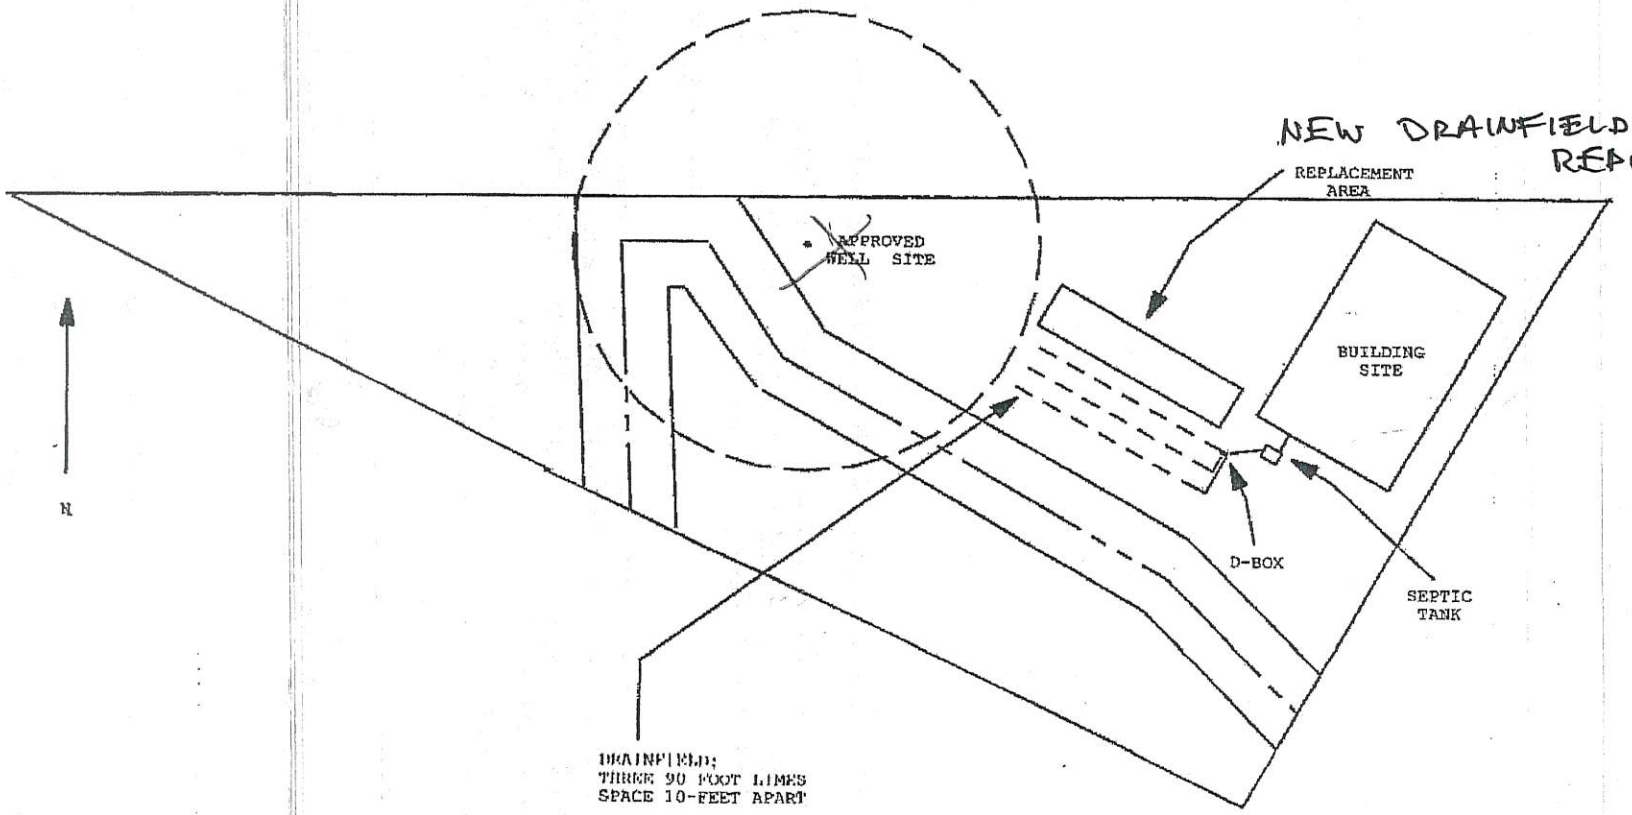

SCALE: 1" = 70'