LINCOLN COUNTY
DEPARTMENT OF ENVIRONMENTAL HEALTH
WASTEWATER TREATMENT AND DISPOSAL SYSTEM PERMIT

Issue Date: 06/28/2022 (Rev 9/13/22) Expiration Date: 06/28/2023-Renewal

Property Owner: Shawn Wilson c/o:

Address: [redacted]

Telephone: [redacted] (Work)

Installer: Homeowner – Requires Inspection License No.

__xx__ New Installation ___ Existing System

____ Repair ____ Replacement ____ Extension ____ Other

Describe: Four 65' laterals using drain rock and perf pipe (see approved trench design)

Parcel Description:

Legal: S9 T36 R27 Big Sky Meadows Unit 4 Lot 3

Address or Location: 194 River Drive, Eureka, MT

Geo/Assessors code: 0000014783

Approved Design Criteria:

Bedrooms 4 Septic Tank Size: 1500 gallons Drainfield Size: 260 Linear Feet

SYSTEM MUST INCLUDE INSTALLATION OF EFFLUENT FILTER AT SEPTIC TANK OUTLET !!

Special Instructions: INSTALL SYSTEM ACCORDING TO LAYOUT, DEQ-4 AND LINCOLN COUNTY WASTEWATER REGULATION #3. ANY DEVIATIONS FROM APPROVED PLAN MUST BE AUTHORIZED BY THE DEPARTMENT.

Issued By: Kathi Hooper, R.S.

Closure Statement:

I, Kathi Hooper *, have inspected this system and found it to be in compliance with the conditions of the permit, and the Lincoln County Wastewater Treatment and Disposal Regulation.*

Signed: _____ *Date:* 12-12-22

Title: Director

NOTICE: The Department must be notified at least 48 hours prior to backfilling the system. Any system not inspected by the Department or its designated representative prior to closure is an illegal installation in violation of Lincoln County Health Board Regulation No. 3. Illegal installations may result in fines and/or requirements to remove or reconstruct the system.

406-283-2442

DISCLAIMER


This permit is not a guarantee by the Department that the system will function properly for a prescribed period of time.

SV

Aug 15/2022

Need to change to following because 86 ft gets us to close to county road & property line.

* Proposed change – from original approved. As-built -

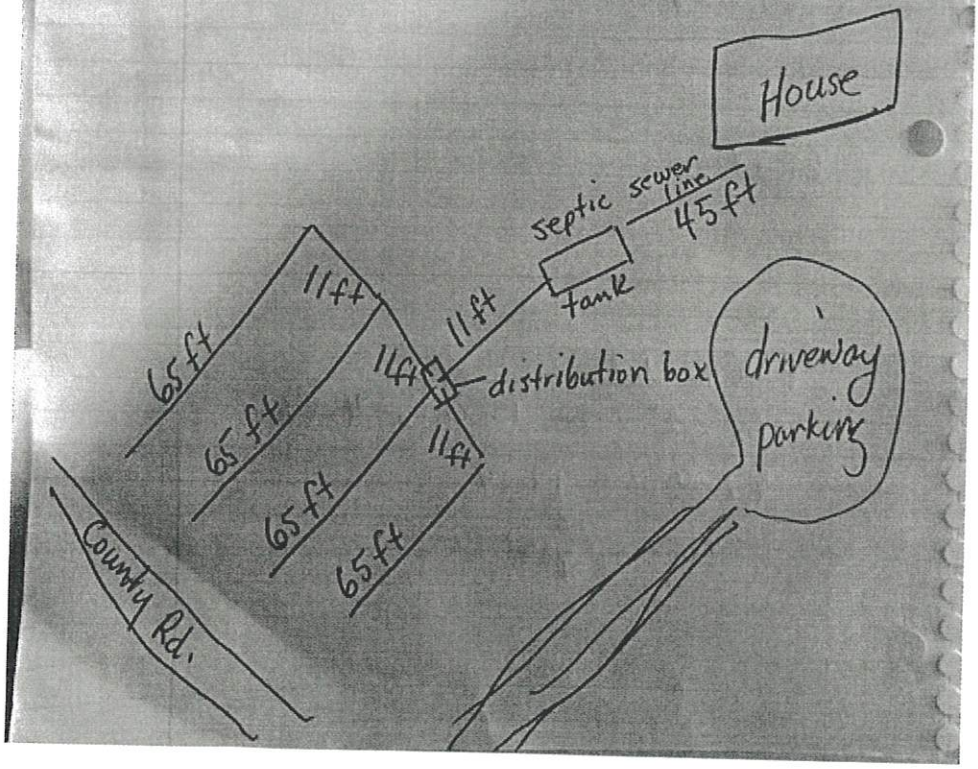

Permit -


BIG SKY MEADOWS LOTS 2 and 3

REVISED

SCALE 1" = 1'-0"

SAND LINED TRENCH - TYPE A

DWG # 2

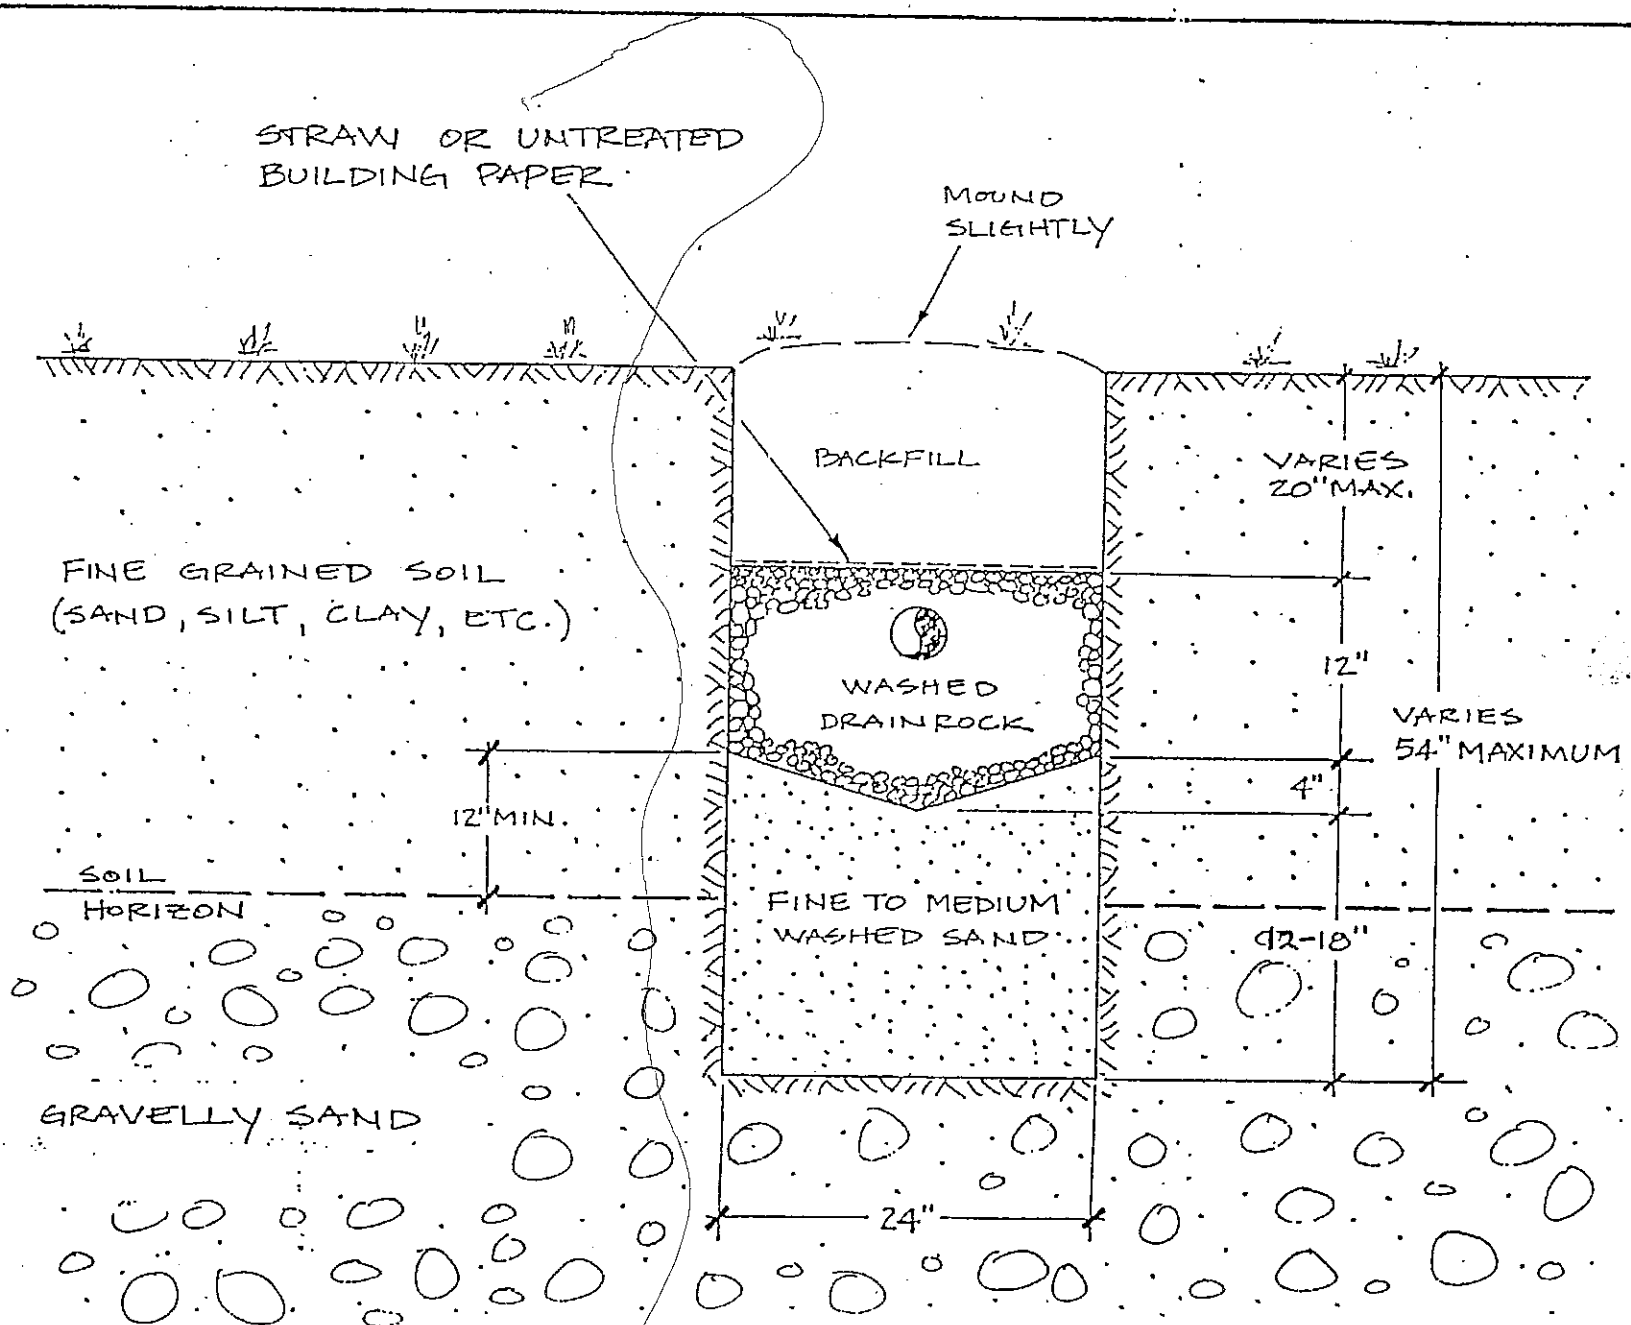

Use this design for soils with perc. rates of 3 min/in to 1 min/in.

Sand Spec's: ASTM C-33 Concrete Sand w/ less than 4% passing the 100 Sieve.