County

LINCOLN COUNTY
DEPARTMENT OF ENVIRONMENTAL HEALTH
WASTEWATER TREATMENT AND DISPOSAL SYSTEM PERMIT

Issue Date: 05/26/2022 Expiration Date: 05/25/2023

Property Owner: Michael Yoder c/o:

Address: [redacted]

Telephone: (Home) (Work)

Installer: Tally Hoe License No. 1

Proposed Work: (Check One) ☐ New Installation ☒ Existing System

☐ Repair ☒ Replacement ☒ Extension ☐ Other _____

Describe: Replace tank & drainfield, two 100' laterals using infiltrators

Parcel Description:

Legal: S10 T28N R30W

Address or Location: 1023 Swamp Creek

Approved Design Criteria:

Bedrooms: 3 Septic Tank Size: 1000 gallons Drainfield Size: 200 lineal feet

SYSTEM MUST INCLUDE INSTALLATION OF EFFLUENT FILTER AT SEPTIC TANK OUTLET!!

Special Instructions: INSTALL SYSTEM ACCORDING TO LAYOUT AND LINCOLN COUNTY WASTEWATER REGULATION #3. ANY DEVIATIONS FROM APPROVED PLAN MUST BE AUTHORIZED BY THE DEPARTMENT. **Provide as built.**

Issued By: *Kathi J. Hooper, R.S.*

Closure Statement:

I, Thomas J Cole, have inspected this system and found it to be in compliance with the conditions of the permit, and the Lincoln County Wastewater Treatment and Disposal Regulation.

Signed: Thomas J Cole *Date:* 5-28-22

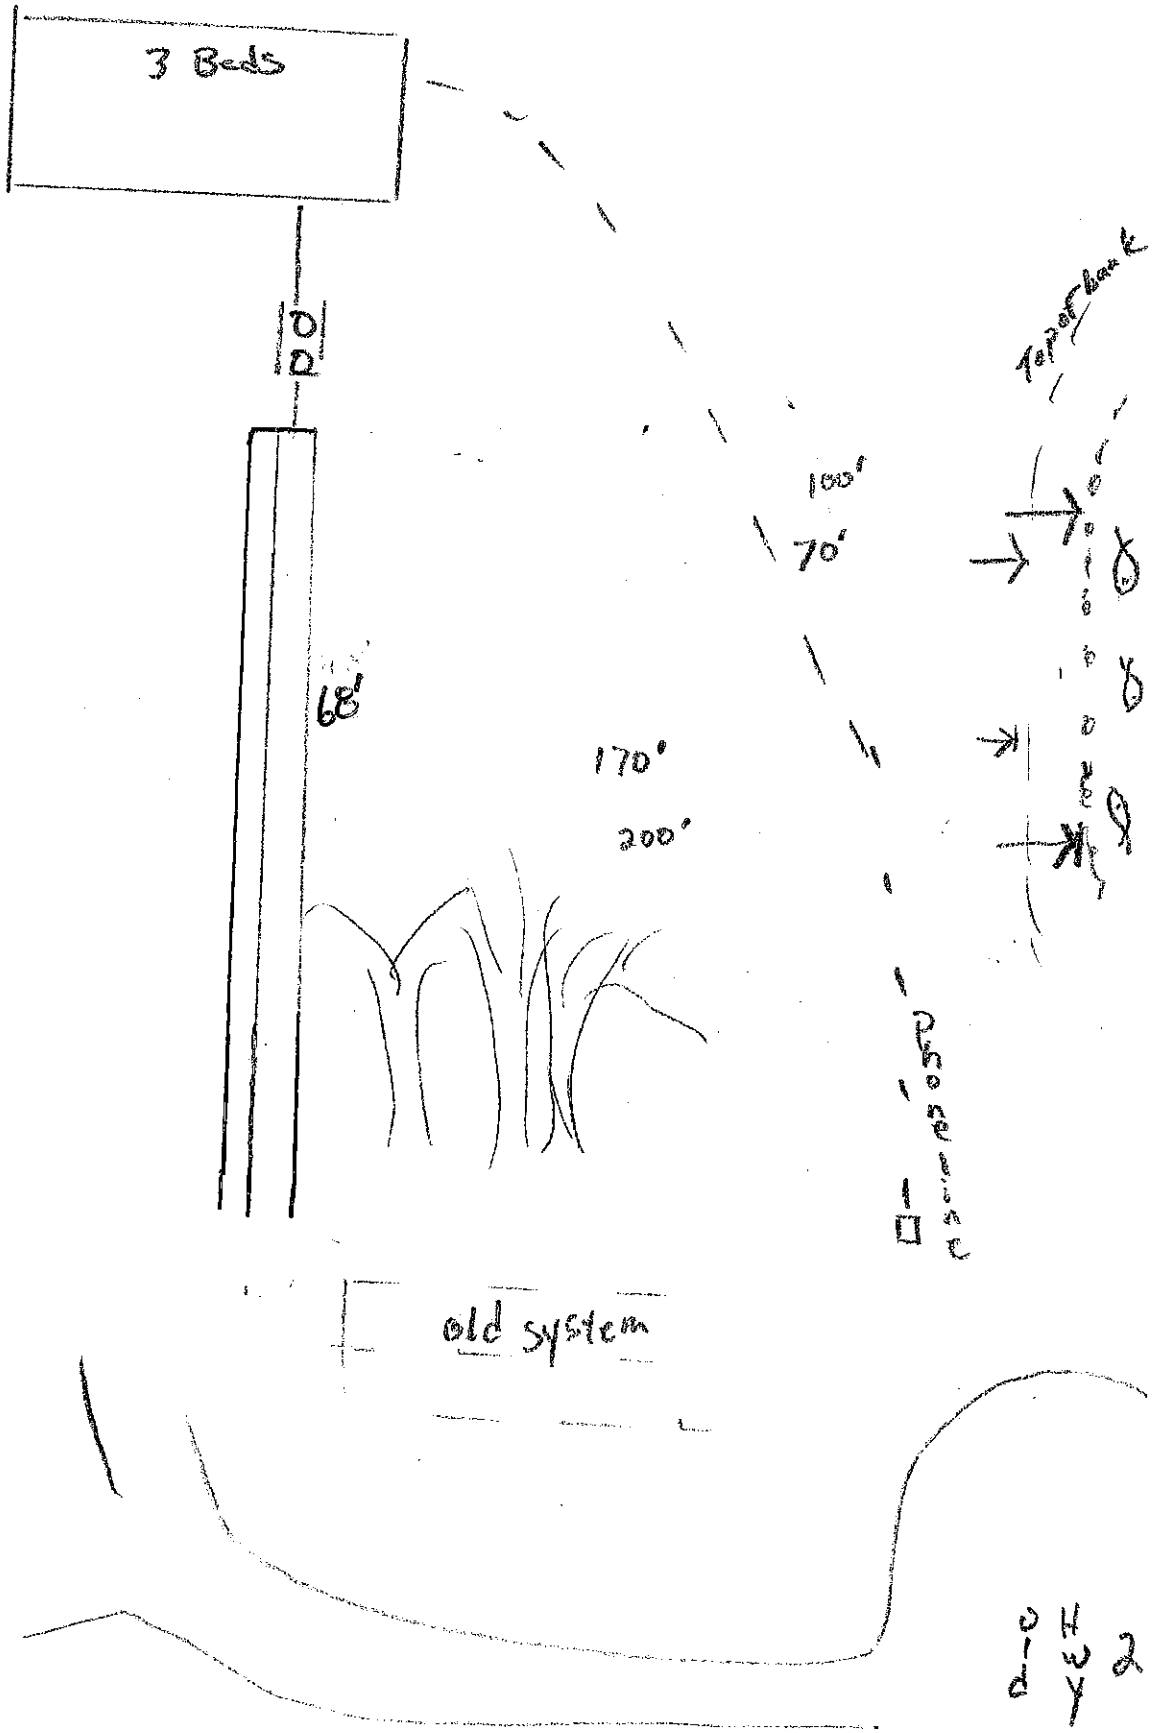
Title: owner operator

NOTICE: The Department must be notified at least 48 hours prior to backfilling the system. Any system not inspected by the Department or its designated representative prior to closure is an illegal installation in violation of Lincoln County Health Board Regulation No. 3. Illegal installations may result in fines and/or requirements to remove or reconstruct the system.

406-283-2442

DISCLAIMER

This permit is not a guarantee by the Department that the system will function properly for a prescribed period of time.


3 Beds
68'
100'
70'
170'
200'
Top of bank
old system
Hwy 2