LINCOLN COUNTY
DEPARTMENT OF ENVIRONMENTAL HEALTH
WASTEWATER TREATMENT AND DISPOSAL SYSTEM PERMIT

Issue Date: 05/05/2022 Expiration Date: 05/05/2023

Property Owner: ZT Properties LLC. c/o:

Address: [redacted]

Telephone: [redacted]

Installer: TBD License No. N/A

__XX__ New Installation ____ Existing System

____ Repair ____ Replacement ____ Extension ____ Other

Describe: 2 - 2,000-gallon septic tanks with effluent filter. Gravity feed system with gravelless absorption trenches (infiltration chambers). 3 laterals at 94-feet in length each.

Parcel Description:

Legal: WALRAVEN, S04, T30 N, R31 W, Lot 017

Address or Location: 125 Woodland Rd., Libby, MT 59923

Geo/Assessors code: 0000010196

Approved Design Criteria:

Bedrooms: 4 – 1 beds Septic Tank Size: 4,000 gallon Drainfield Size: 282 Linear Feet

SYSTEM MUST INCLUDE INSTALLATION OF EFFLUENT FILTER AT SEPTIC TANK OUTLET !!

Special Instructions: ***INSTALL SYSTEM ACCORDING TO LAYOUT, DEQ-4 AND LINCOLN COUNTY WASTEWATER REGULATION #3. ANY DEVIATIONS FROM APPROVED PLAN MUST BE AUTHORIZED BY THE DEPARTMENT.*** **Exact configuration/layout of tanks unknown at time of permitting. Applicant to provide revised layout and/or as-built once determined.**

Issued By: *Nicholas Raines*

Closure Statement:

I, _____, have inspected this system and found it to be in compliance with the conditions of the permit, and the Lincoln County Wastewater Treatment and Disposal Regulation.

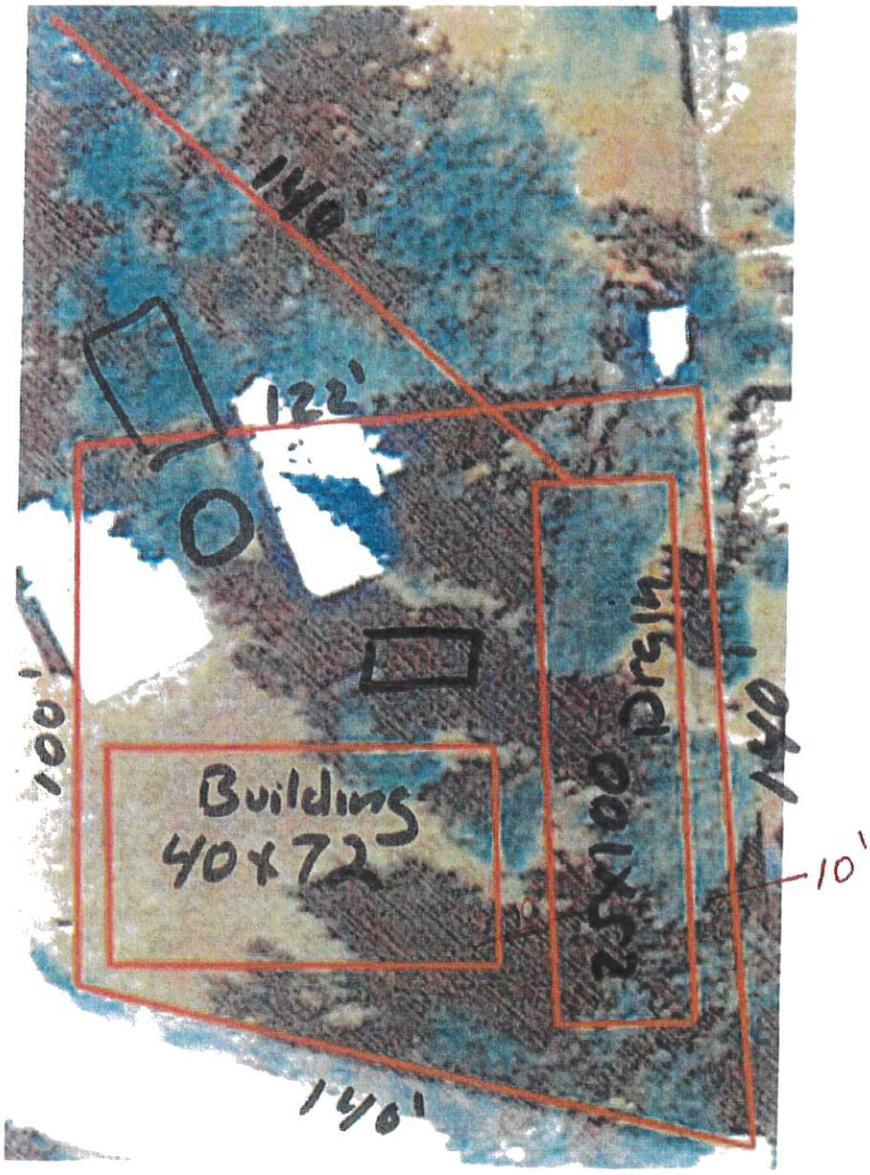
Signed: _____ *Date:* _____

Title: _____

NOTICE: The Department must be notified at least 48 business hours prior to backfilling the system. Any system not inspected by the Department or its designated representative prior to closure is an illegal installation in violation of Lincoln County Health Board Regulation No. 3. Illegal installations may result in fines and/or requirements to remove or reconstruct the system.
406-283-2442

DISCLAIMER

This permit is not a guarantee by the Department that the system will function properly for a prescribed period of time.


140'
122'
100'
Buildings
40x72
Drain
140'
10'