LINCOLN COUNTY
DEPARTMENT OF ENVIRONMENTAL HEALTH
WASTEWATER TREATMENT AND DISPOSAL SYSTEM PERMIT

Issue Date:11/18/2021 Expiration Date: 11/18/2022

Property Owner: Cameron & Cathy Foote c/o:

Address: [redacted]

Telephone: [redacted] (Work)

Installer: Self (Dustin Welch will sign off) License No.

__XX__ New Installation ____ Existing System

____ Repair ____ Replacement ____ Extension ____ Other- Renewal (MD)

Describe: Gravity system with 1,000 gallon septic tank. Gravelless, (chambers) with 3 laterals @ 50 lineal feet each.

Parcel Description:

Legal: WILDERNESS PLATEAU, S19, T31 N, R33 W, BLOCK 003, Lot 033, ACRES 0.506

Address or Location: Lot 033

Geo/Assessors code: 0000011131

Approved Design Criteria:

Bedrooms: 3 Septic Tank Size: 1000 gallons Drainfield Size: 150 Lineal Feet

Special Instructions: Laterals to be spaced by at least 5-feet from trench wall to trench wall. For this permit to be considered valid, the installer must provide signed closure statement along with an as-built layout depicting the final location of the drainfield.

INSTALL SYSTEM ACCORDING TO LAYOUT, DEQ-4 AND LINCOLN COUNTY WASTEWATER REGULATION #3. ANY DEVIATIONS FROM APPROVED PLAN MUST BE AUTHORIZED BY THE DEPARTMENT.

Issued By: Kathi Hooper, R.S.

Closure Statement:

I, Dustin Welch, have inspected this system and found it to be in compliance with the conditions of the permit, and the Lincoln County Wastewater Treatment and Disposal Regulation.

Signed: _____ *Date:* 6-3-22

Title: _____


NOTICE: The Department must be notified at least 48 hours prior to backfilling the system. Any system not inspected by the Department or its designated representative prior to closure is an illegal installation in violation of Lincoln County Health Board Regulation No. 3. Illegal installations may result in fines and/or requirements to remove or reconstruct the system.

406-283-2442

DISCLAIMER

This permit is not a guarantee by the Department that the system will function properly for a prescribed period of time.

LOT LAYOUT

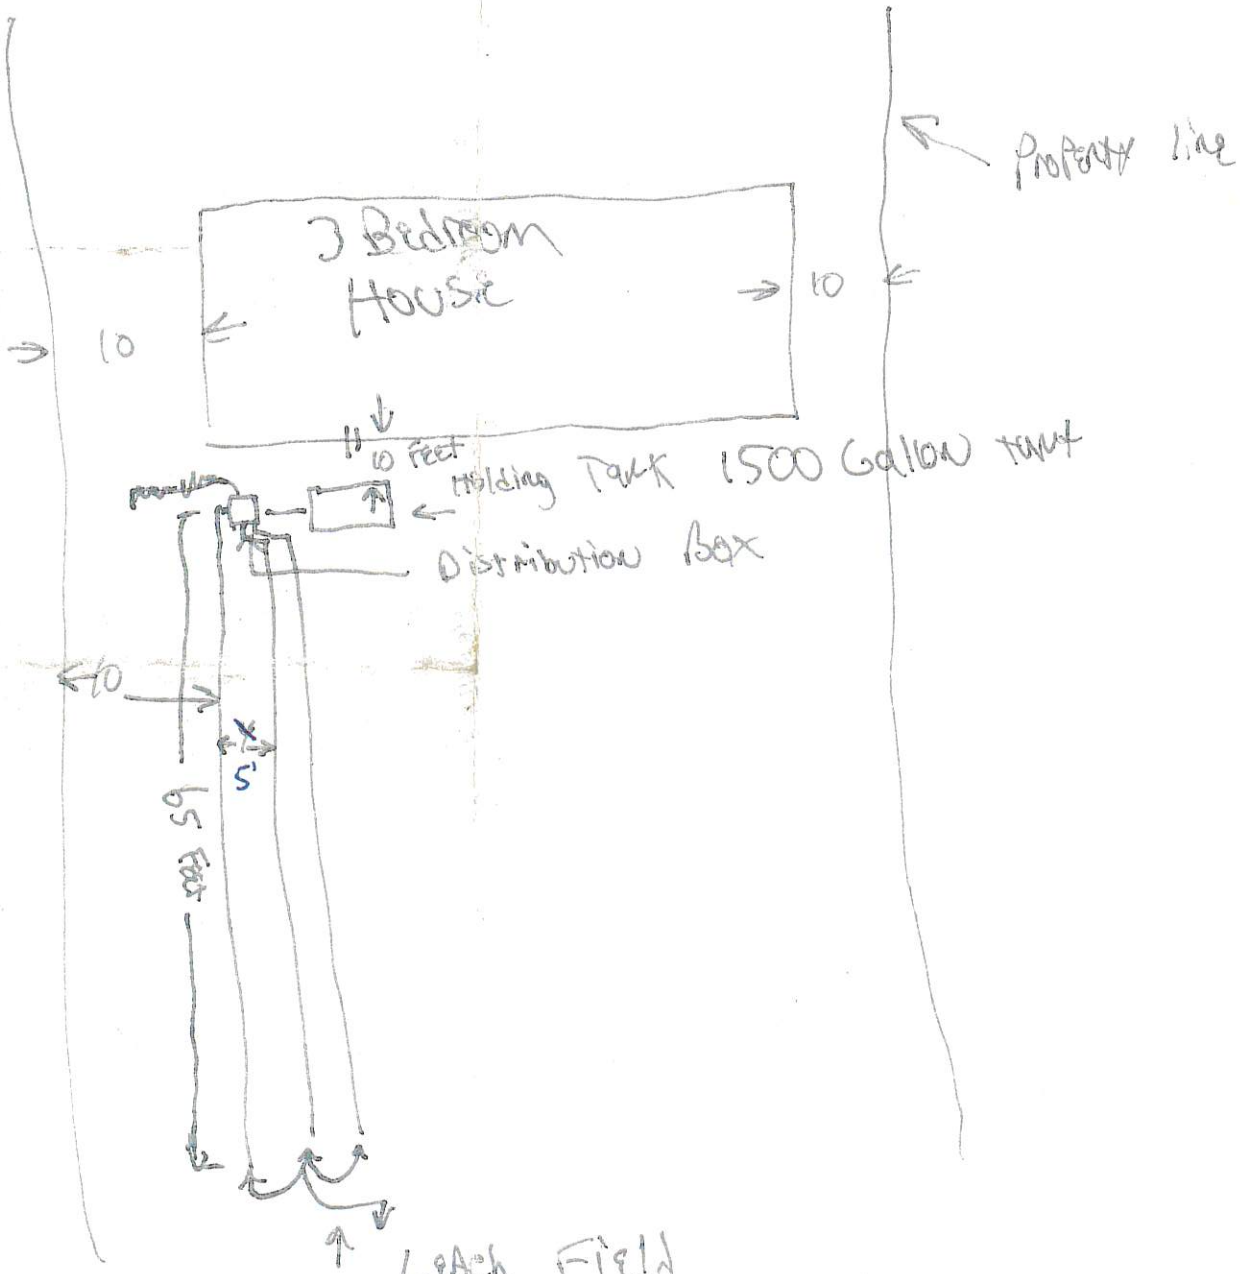

3 Lines ~~65~~ 50 Feet Long

Arc Leach field Chambers will be used (Domes)