County

LINCOLN COUNTY
DEPARTMENT OF ENVIRONMENTAL HEALTH
WASTEWATER TREATMENT AND DISPOSAL SYSTEM PERMIT

Issue Date: 03/09/2022 Expiration Date: 03/09/2023

Property Owner: Guthneck, Mike c/o:

Address: [redacted]

Telephone: N/A

Installer: Tally Hoe License No. 1

___ New Installation ____ Existing System

____ Repair __XX__ Replacement ____ Extension ____ Other

Describe: 1,000-gallon septic tank with effluent filter. Gravity feed system with graveless trenches (infiltrators). 2 laterals at 84-feet in length each (assumes 0.8 gpd/ft2 application rate). Lineal footage will be adjusted as needed based on soil conditions. As-built will be provided if lineal footage is adjusted.

good Rock Sand gravel

Parcel Description:

Legal: S32, T29 N, R30 W, TR 4A8 IN N2NENW

Address or Location: 233 Elliott Creek Rd, Libby, MT 59923

Geo/Assessors code: 0000002605

Approved Design Criteria:

Bedrooms 3 Septic Tank Size: 1,000 gallon Drainfield Size: 168 Linear Feet

SYSTEM MUST INCLUDE INSTALLATION OF EFFLUENT FILTER AT SEPTIC TANK OUTLET !!

Special Instructions: INSTALL SYSTEM ACCORDING TO LAYOUT, DEQ-4 AND LINCOLN COUNTY WASTEWATER REGULATION #3. ANY DEVIATIONS FROM APPROVED PLAN MUST BE AUTHORIZED BY THE DEPARTMENT. **SEPTC TANK TO BE INSTALLED AT LEAST 50-FEET FROM THE EXISTING WELL.**

Issued By: Nicholas Raines

Closure Statement:

I, Thomas J Cole *, have inspected this system and found it to be in compliance with the conditions of the permit, and the Lincoln County Wastewater Treatment and Disposal Regulation.*

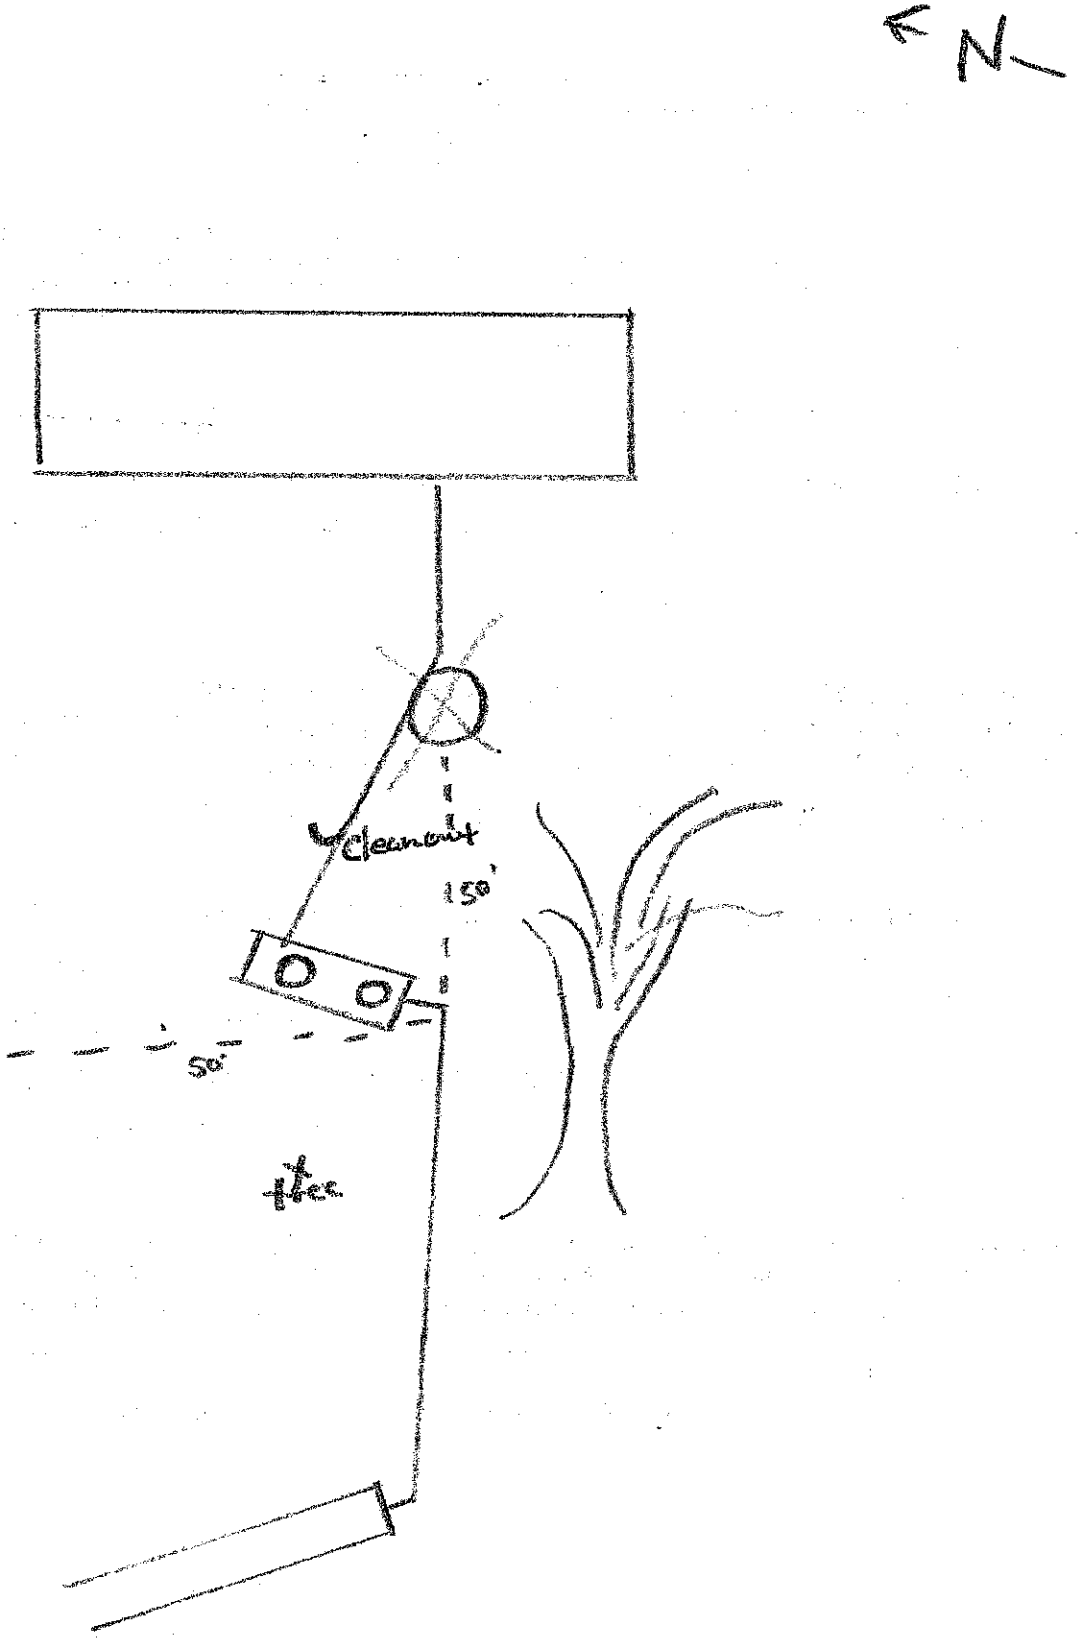
Signed: Thomas J Cole *Date:* 3-15-22

Title: owner

NOTICE: The Department must be notified at least 48 hours prior to backfilling the system. Any system not inspected by the Department or its designated representative prior to closure is an illegal installation in violation of Lincoln County Health Board Regulation No. 3. Illegal installations may result in fines and/or requirements to remove or reconstruct the system.
406-283-2442

DISCLAIMER

This permit is not a guarantee by the Department that the system will function properly for a prescribed period of time.


N
clearance
150'
50'
tee