LINCOLN COUNTY HEALTH DEPARTMENT
ENVIRONMENTAL HEALTH
WASTEWATER TREATMENT AND DISPOSAL SYSTEM PERMIT

Issue Date: 11/21/2024 Expiration Date: 11/20/2025 Permit#24-3353

Property Owner: Yancy Wroble

Mailing Address: [redacted]

Installer: Franklin Fifield License #: 198

Approved Work: (Check One) ☐ New Installation ☐ Existing System

☒ Replace Drainfield ☐ Replace Tank ☐ Extension

Describe: Installation of new gravity system to replace system never installed for 3 Bedroom House.

Legal: VICKS TRACTS, S24, T30 N, R31 W, LOT S15, ACRES 0.5 S2S2 OF LOTS 15&16

Property Address: 79 Vicks Ct., Libby, MT 59923 Assessment Code: 3353

DEQ COSA: E.Q.# Date:

Approved Design Criteria: Installation of new gravity system for 3 Bedroom House with 3 Laterals @ 52' with reduction for chambers.

# of Bedrooms: 3 Septic Tank Size: 1000 gallons Trench Width:24"

# of Laterals: 3 Length of Laterals: 52' Trench Depth: 24"-36"

SYSTEM MUST INCLUDE INSTALLATION OF EFFLUENT FILTER AT SEPTIC TANK OUTLET!!

Special Instructions: Install system according to the COSA, lot layout, the Lincoln County Wastewater Treatment and Disposal Regulation, and Circular DEQ-4. Reduction given for chambers. It is the installer's responsibility to ensure that all required horizontal setbacks are met. CHANGES MUST BE PRE-AUTHORIZED BY THE DEPARTMENT.

Issued By: *Robin Blumberg, RS*

NOTICE: The Department must be notified at least 3 business days (72 hours) prior to backfilling the system. Call 406-283-2442. Any system not inspected by the Department or its designated representative prior to closure is an illegal installation in violation of Lincoln County Health Board Regulation Ch. 3. Illegal installations may result in fines and/or requirements to remove or reconstruct the system.

Closure Statement:

This system is in compliance with the approved design criteria and Lincoln County's Wastewater Treatment and Disposal Regulation.


Signed: Robin Blumberg *Date:* 7/16/25

____ Lincoln County Health Department (LCHD) ____ Licensed Installer w/ approval of LCHD

This permit is not finalized until the system is inspected and the closure statement is signed.

This permit is not a guarantee that the system will function properly for a prescribed period of time.

"As Built" Lot Layout
Snowshoe Peak Investments - Yancy Wrable
79 Vicks Court, Libby MT

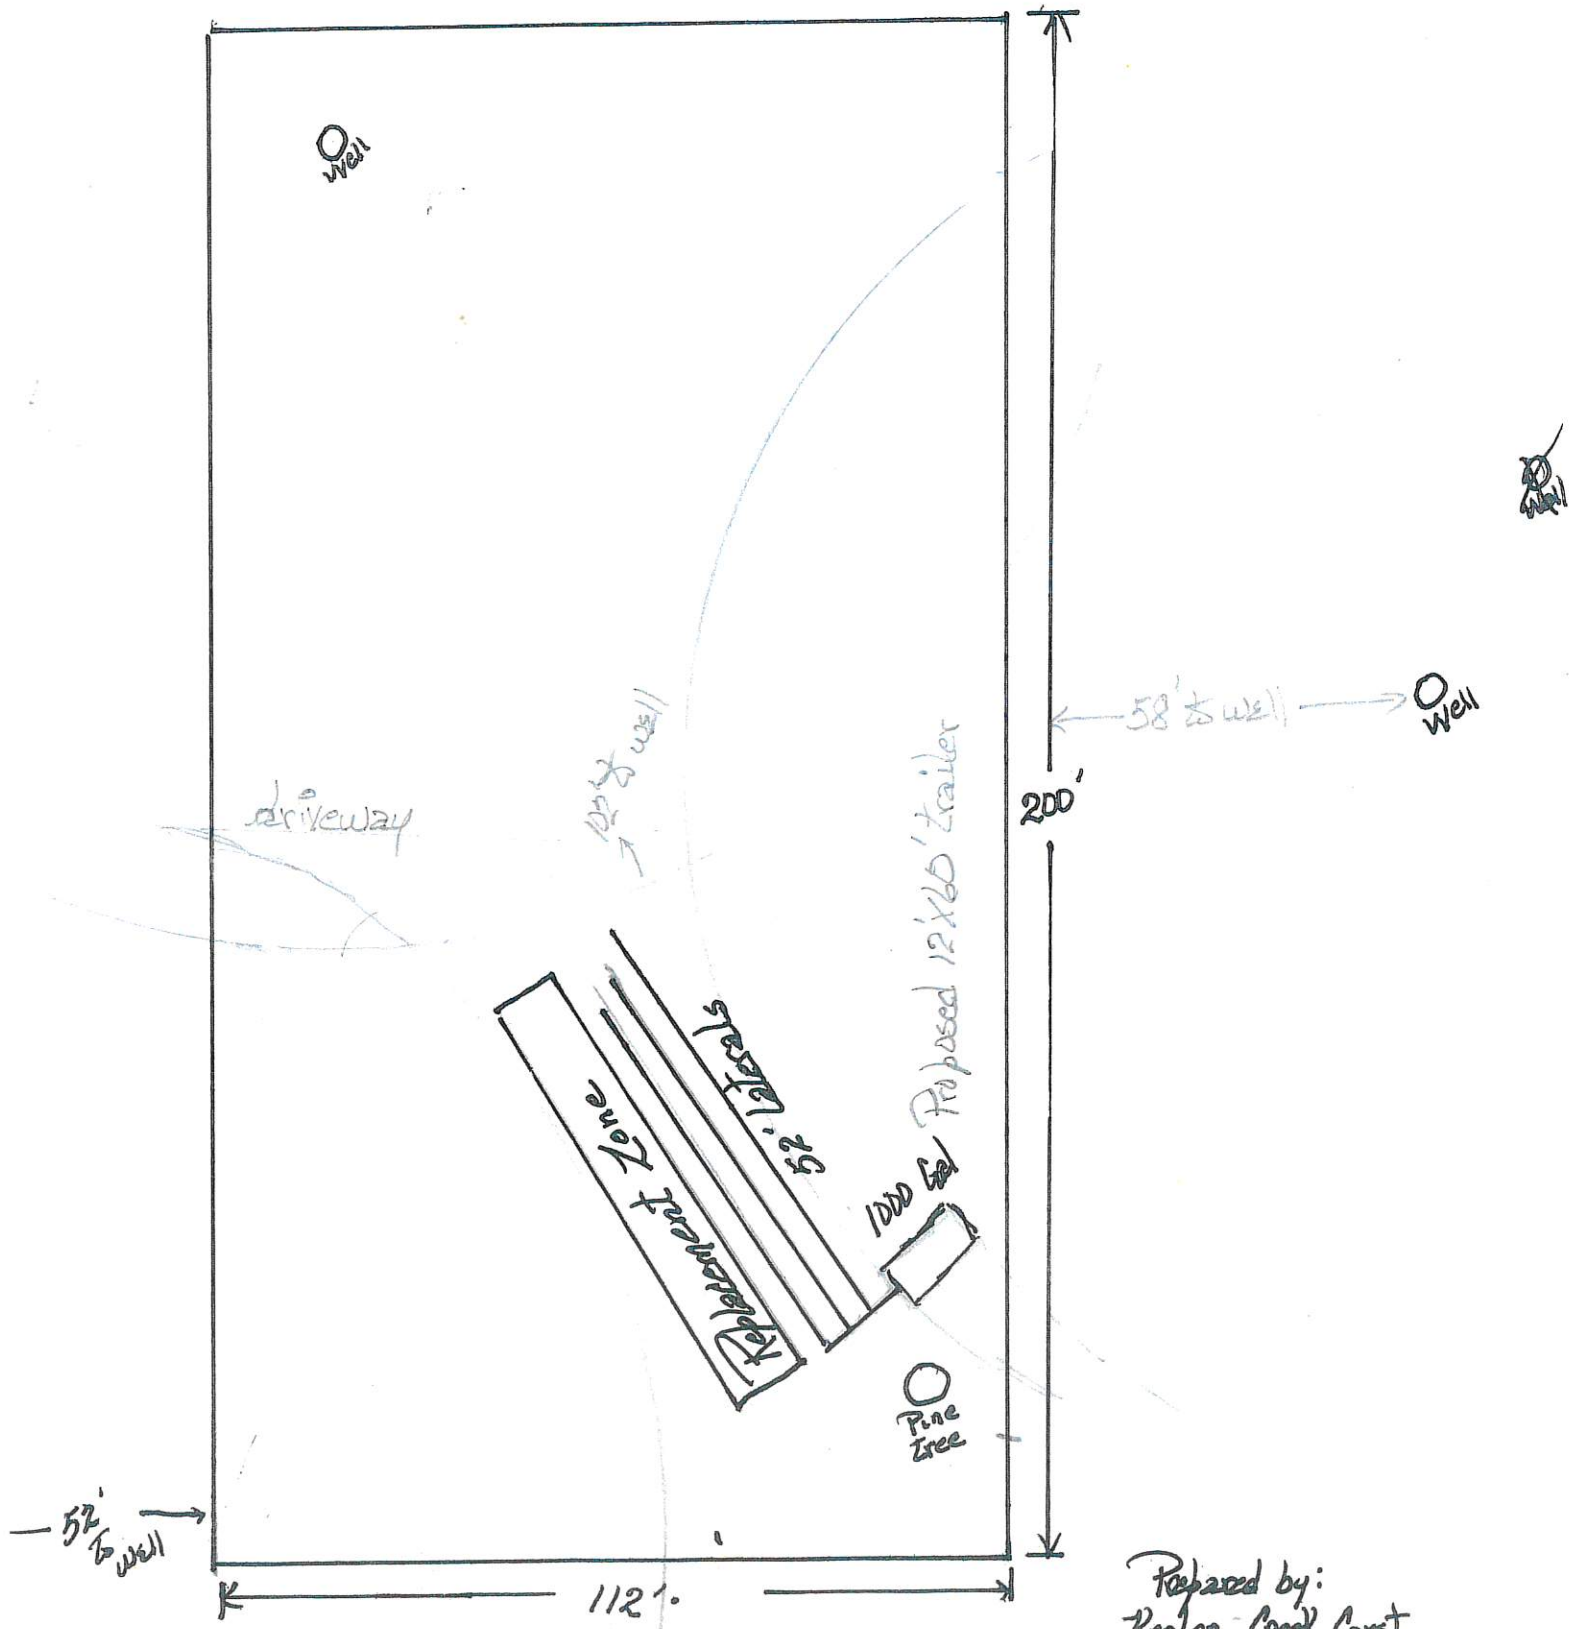

Scale: 1" = 25'

Prepared by:
Reeler Geek Const
July 20, 2025