Issue Date: 9-22-00 Expiration Date: 9-22-00

Property Owner: SUSAN FANNING AND DALE FANNING

Address: [redacted]

Telephone: (Home) [redacted] (Work) _____

Installer: Self License No. NA

X New Installation _____ Existing System

_____ Repair _____ Replacement _____ Extension _____ Other

Describe: _____

Parcel Description:

Legal: SE¼ NW¼ Sec 29 T36 R27

Address or Location: 1820 OTHORP LAKE ROAD

Approved Design Criteria:

Bedrooms 3 Septic Tank Size: 1000 gallons Drainfield Size: 290 lineal feet

INSTALL SYSTEM AS PER APPROVED SITE PLAN (LOT LAYOUT) AND LINCOLN COUNTY WASTEWATER REGULATION #3.

Special Instructions: System was installed several years ago, but was inspected and approved 9/21/00 as having met the requirements of the time of installation Issued By: [signature]

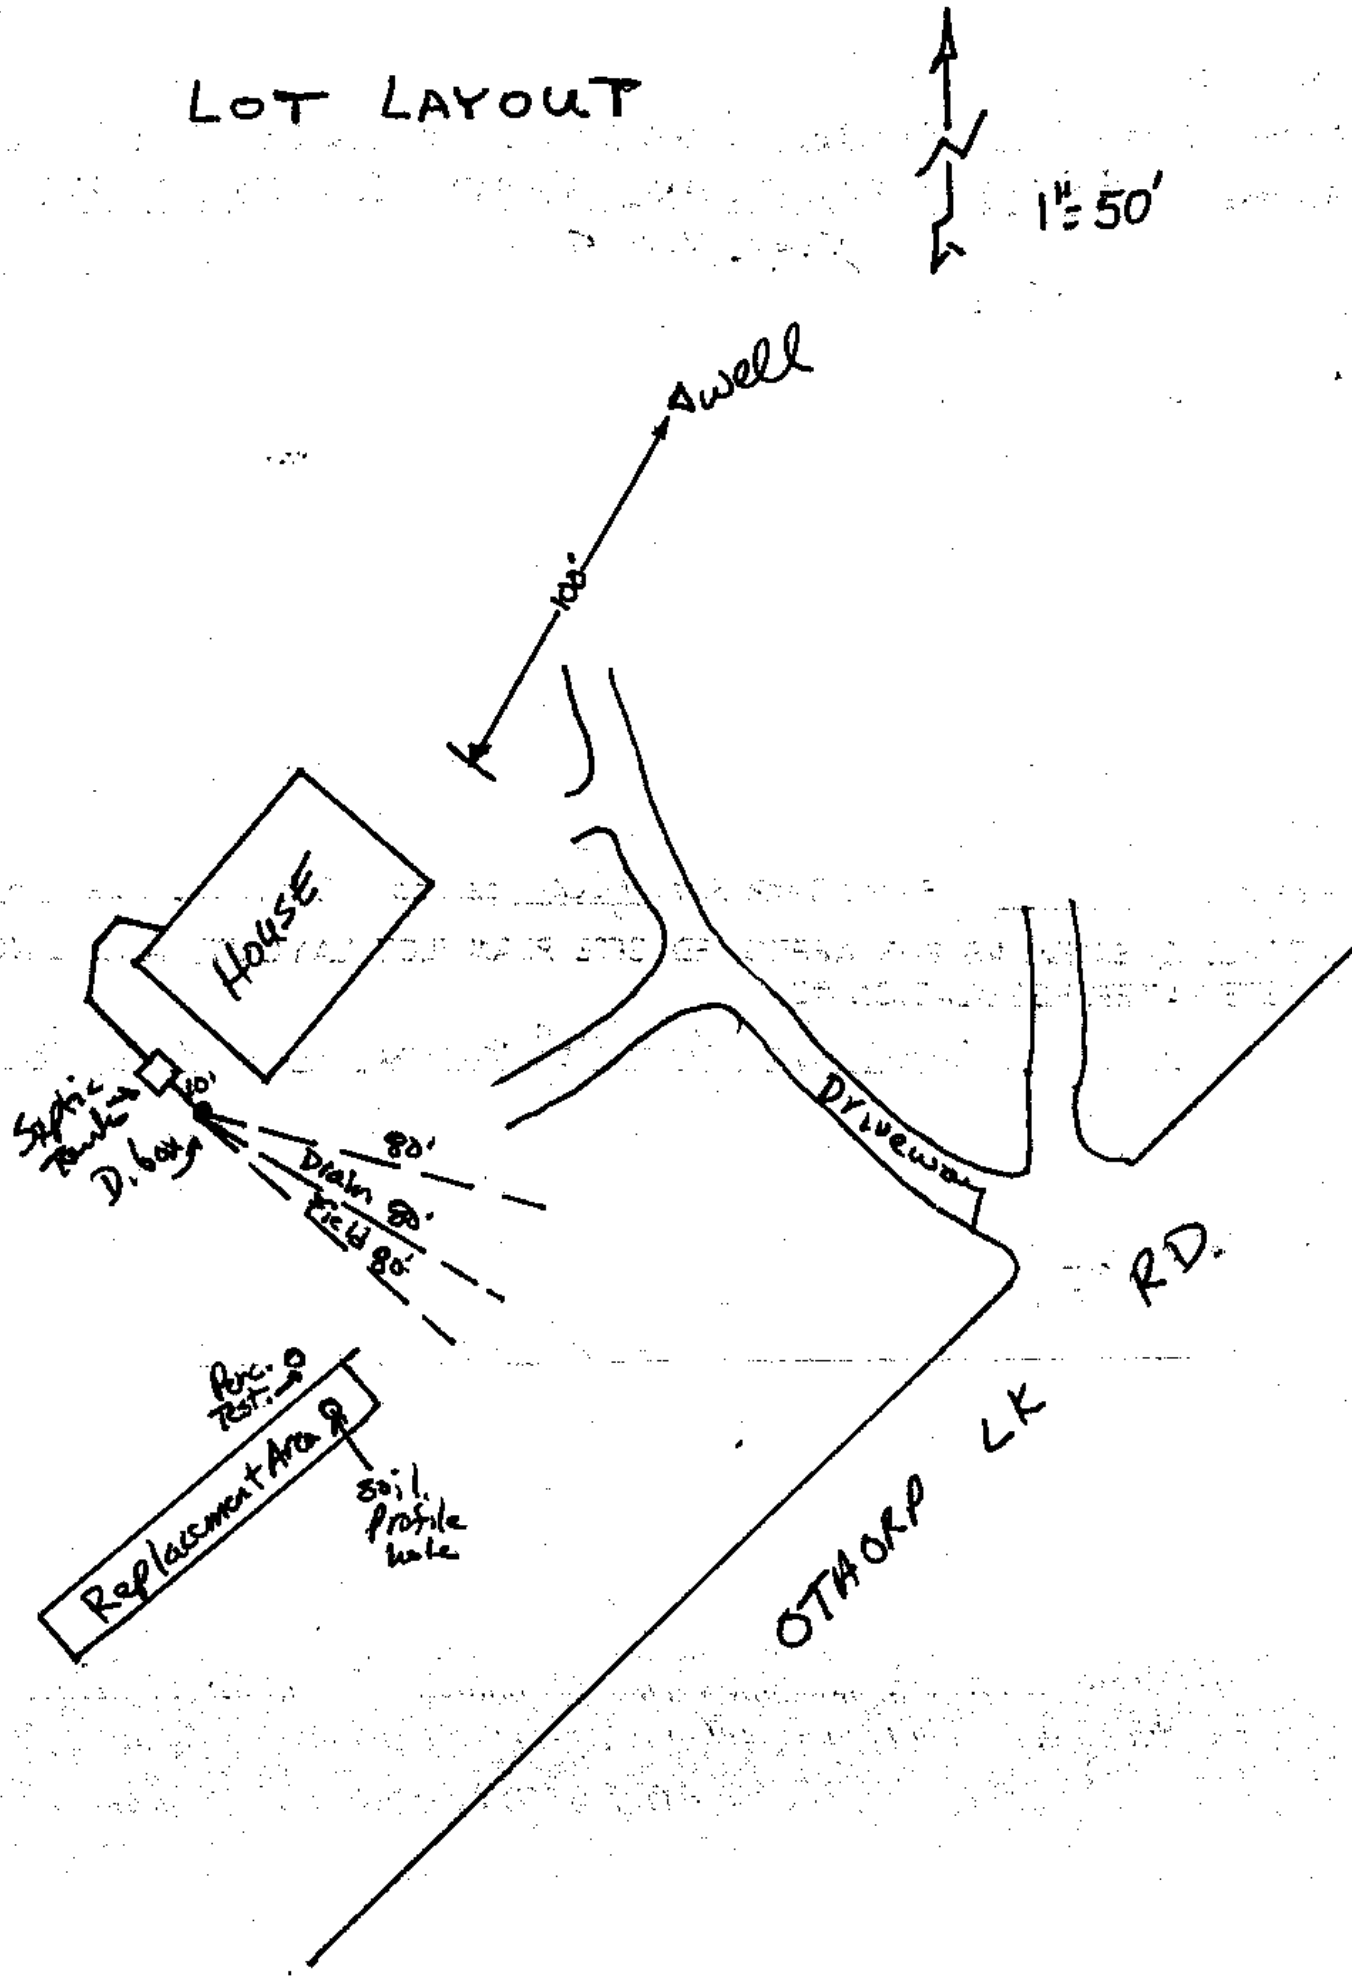
Closure Statement:

I, Michael Nelson, have inspected this system and found it to be in compliance with the conditions of the permit, and the Lincoln County Wastewater Treatment and Disposal Regulation.

Signed: [signature] Date: Sept 26 2000

Title: Septic tank installer Lic. #08

LOT LAYOUT


1" = 50'
Well
100'
House
Septic Tank
D. box
30'
80'
Drain Field
80'
80'
Driveway
RD.
Perc. Test
Replacement Area
Soil Profile Hole
OTHORP LK