County

LINCOLN COUNTY
DEPARTMENT OF ENVIRONMENTAL HEALTH
WASTEWATER TREATMENT AND DISPOSAL SYSTEM PERMIT

Issue Date: 06/05/2020 Expiration Date: 06/05/2021

Property Owner: Vickie Lausen c/o:

Address: [redacted]

Telephone: [redacted] (Home) (Work)

Installer: Tom Cole License No. 1

__XX__ New Installation ___ Existing System

____ Repair ____ Replacement ____ Extension ____ Other

Describe: Three ~~76'~~ Laterals using chambers three 100' laterals

Parcel Description:

Legal: TR 1O & 1N IN S1/2SW OR TR 2 CS #2353 12.82 ACRES SPLIT FROM #2621

Address or Location: TR 2

Geo/Assessors code: 0000014197

Approved Design Criteria:

Bedrooms 3 Septic Tank Size: 1000 gallons Drainfield Size: ~~228~~ 300 lineal feet

SYSTEM MUST INCLUDE INSTALLATION OF EFFLUENT FILTER AT SEPTIC TANK OUTLET !!

Special Instructions: INSTALL SYSTEM ACCORDING TO LAYOUT, DEQ-4 AND LINCOLN COUNTY WASTEWATER REGULATION #3. ANY DEVIATIONS FROM APPROVED PLAN MUST BE AUTHORIZED BY THE DEPARTMENT.

Issued By: Jake Mertes, R.S.

Closure Statement:

I, Thomas J Cole *, have inspected this system and found it to be in compliance with the conditions of the permit, and the Lincoln County Wastewater Treatment and Disposal Regulation.*

Signed: Thomas J Cole *Date:* 6-20-20

Title: owner operator

NOTICE: The Department must be notified at least 48 hours prior to backfilling the system. Any system not inspected by the Department or its designated representative prior to closure is an illegal installation in violation of Lincoln County Health Board Regulation No. 3. Illegal installations may result in fines and/or requirements to remove or reconstruct the system.

406-283-2442

DISCLAIMER


This permit is not a guarantee by the Department that the system will function properly for a prescribed period of time.

LOT LAYOUT
"LAUSEN TRACT 2 (RSR)"

SW¼ SECTION 9, T.30N., R.31W. P.M., MT.
LINCOLN COUNTY, MONTANA

Reviewed by the Local Reviewing Authority under contract with the Department of Environmental Quality/ PCD
Local Reviewer — Date

Accepted under contract
DEQ Representative — Date
DEQ #11-1269

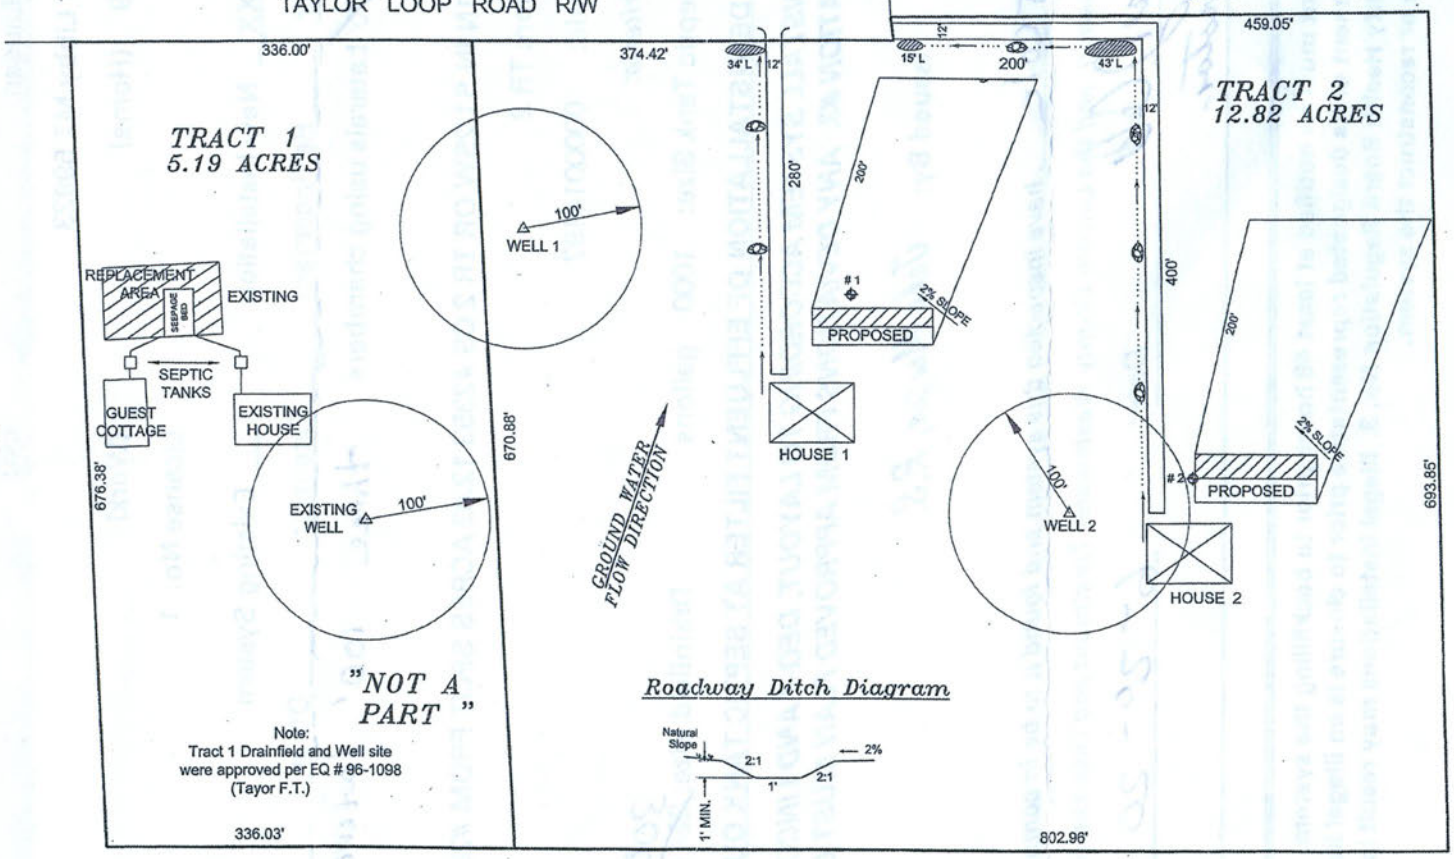

N

SCALE
1" = 100'

**** NOTES ****

NO WELLS OR DRAINFIELDS WITHIN 100' OF PROPERTY BOUNDARY OTHER THAN THOSE SHOWN. THE PROPERTY OWNER IS RESPONSIBLE FOR THE MAINTENANCE OF THE STORM DRAINAGE STRUCTURES.


LEGEND

- Proposed WELL SITE
- SOIL TEST SITE
- PROPOSED HOUSE SITE (50'X70')
- DRAINFIELD AND REPLACEMENT AREA
- STORM WATER SWALE (LENGTHS SHOWN)
- ROCK FILTER DAM
- Proposed DRIVEWAY
- DRAINAGE DITCH & STORMWATER FLOW


Note:
Tract 1 Drainfield and Well site were approved per EQ # 96-1098 (Tayor F.T.)

Roadway Ditch Diagram

Rock Filter Dam

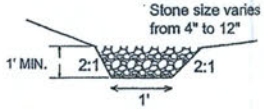

Swale Cross Section

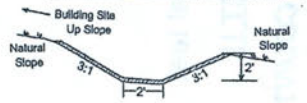

PREPARED BY: JOHN W. PETERSON

KSI