LINCOLN COUNTY
DEPARTMENT OF ENVIRONMENTAL HEALTH
WASTEWATER TREATMENT AND DISPOSAL SYSTEM PERMIT

RE-15348

Issue Date: 2/1/2019 Expiration Date: 2/1/~~2020~~ 2021

Property Owner: Jennifer Meyer c/o:

Address: [redacted]

Telephone: (Home) (Work)

Installer: ~~Self~~ Melvin D Smith License No. 99

__xx__ New Installation ____ Existing System

____ Repair ____ Replacement ____ Extension ____ Other

Describe: Three 70' laterals using drain rock and perfpipe.

Parcel Description:

Legal: S2 T31 R34

Address or Location: Valley Tracts Lot 6

Geo/Assessors code: 0000009826

Approved Design Criteria:

Bedrooms 2 Septic Tank Size: 1000 gallons Drainfield Size: 210 Linear Feet

SYSTEM MUST INCLUDE INSTALLATION OF EFFLUENT FILTER AT SEPTIC TANK OUTLET !!

Special Instructions: INSTALL SYSTEM ACCORDING TO LAYOUT, DEQ-4 AND LINCOLN COUNTY WASTEWATER REGULATION #3. ANY DEVIATIONS FROM APPROVED PLAN MUST BE AUTHORIZED BY THE DEPARTMENT.

Issued By: Jake Mertes, R.S.

Closure Statement:

I, _____, have inspected this system and found it to be in compliance with the conditions of the permit, and the Lincoln County Wastewater Treatment and Disposal Regulation.


Signed: Melvin D Smith *Date:* 5-14-2000

Title: _____

NOTICE: The Department must be notified at least 48 hours prior to backfilling the system. Any system not inspected by the Department or its designated representative prior to closure is an illegal installation in violation of Lincoln County Health Board Regulation No. 3. Illegal installations may result in fines and/or requirements to remove or reconstruct the system.

406-283-2442

LINCOLN COUNTY, MONTANA
SEPTIC TANK PERMIT
VALLEY TRACTS
IN THE NE 1/4 OF SECTION 2
TWP. 31 N., R. 34 W., P.M.M.
FOR: Jennifer McYer (Re-issue) DATE: 2-1-2019
LOT 6

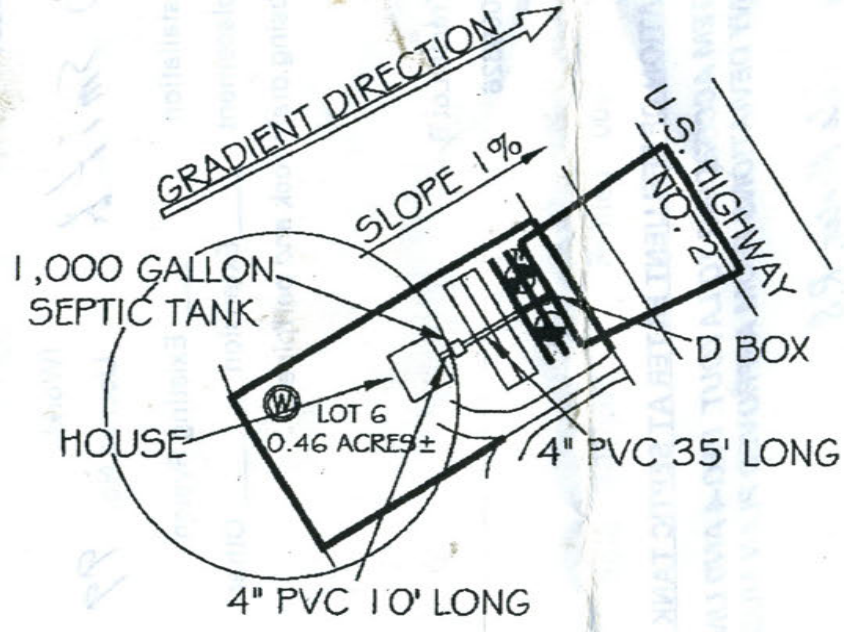

LEGEND
- SOILS PROFILE
- PERCOLATION SITE
- PROPOSED WELL SITE
- SLOPE
- GRADIENT DIRECTION
- PROPOSED SEPTIC SITE 3-70' TRENCHES 10' APART
- REPLACEMENT SITE 3-70' TRENCHES 10' APART
- 100' MIXING ZONE

06/20/05

SCALE
1 INCH = 100 FT.

Davis Surveying Inc.
TROY MONTANA, (406)295 5441

DATE: 6/18/05	
DRAWN BY: MDM	FILE: 31r34e2.DWG