LINCOLN COUNTY
DEPARTMENT OF ENVIRONMENTAL HEALTH Permit #25-55092
AFFIDAVIT OF WASTEWATER TREATMENT AND DISPOSAL SYSTEM COMPLIANCE REVIEW FOR SYSTEM INSTALLED, REPAIRED OR REPLACED WITHOUT A VALID PERMIT

Issue Date: 01/17/2025

Property Owner: Stephan and Orpha Girod

Mailing Address: 40149 US Hwy 2 Libby, MT 59923

Name of Person Who Installed System Being Reviewed: Billie Gardner License # 177

Type of System Work Reviewed:

_x_ New Installation ____ Existing System

____ Repair ____ Replacement ____ Extension ____ Other

Describe: New installation of gravity system for 4 Bedroom House +2 Bedroom House with 5 laterals @ 100' with chambers.

Property Description:

Legal: VALHALLA ESTATES, S12, T29 N, R31 W, ACRES 28.8, PM 7198 LOT 1

Address or Location: 40161 US HWY 2, Libby, MT 59923

Reviewed Design Components: Billie Gardner

Septic Tank: 1000 Gallon +1500 Gallon Effluent Filter: Yes

Dosing or Lift Tank: No Drainfield Size: 5 Laterals @100' Trench Depth: 36" Trench Width: 24"

Assessment code: 55092

Comments: From Installer: Reviewed site details with sanitarian and was given design requirements, system was installed as per all specifications w/o permit at the time of his tragic demise.

System Review Documentation Statement:

I, Robin Blumberg, have reviewed the components of this system as listed above and found it to be in compliance with the sizing, construction, orientation and operating requirements of Chapter 17, Subchapter 9 A.R.M., Circular DEQ-4 and Lincoln County Wastewater Regulation #3.

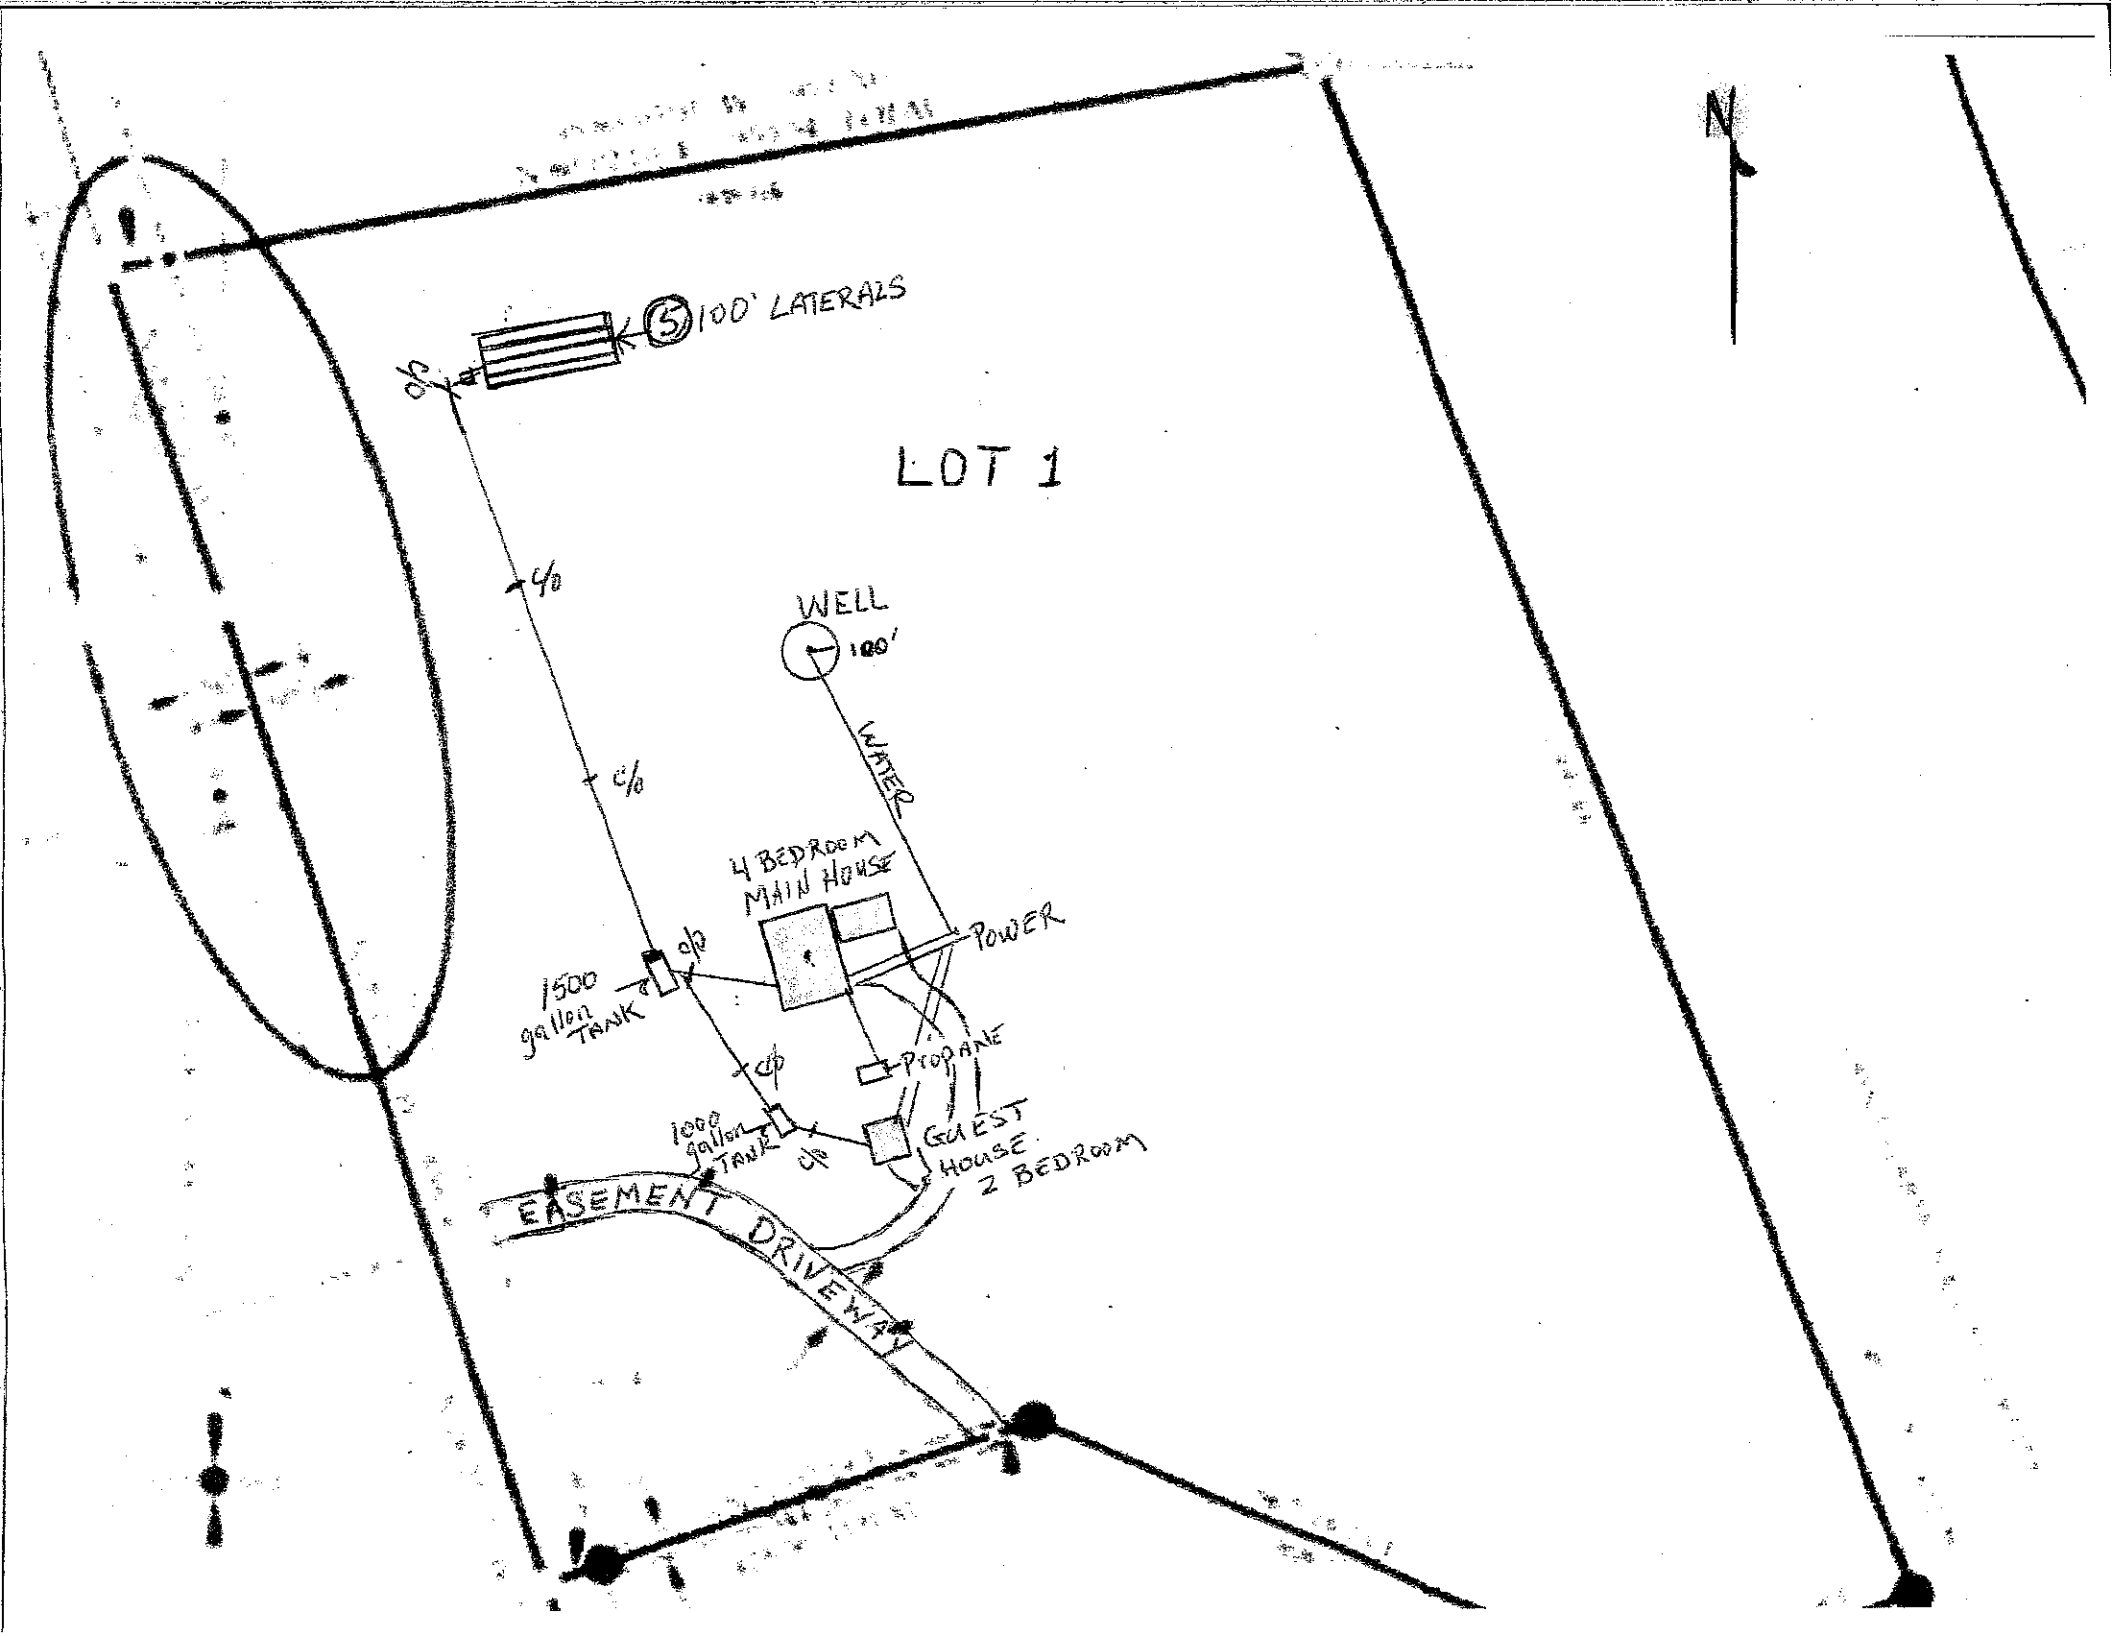
Signed: Robin Blumberg *Date:* 1/17/2025

Title: R.S.

NOTICE: This document is not a permit for installation, repair or alterations of a wastewater treatment system. It is merely a statement of affirmation that the Department has conducted a review of an otherwise illegal system and found it to be in compliance with all applicable requirements for that system. This affidavit effectively removes the illegal installation status on this system.

DISCLAIMER

This affidavit of review is not a guarantee by the Department that the system will continue to function properly for any prescribed period of time.


N
5 100' LATERALS
LOT 1
WELL
100'
WATER
4 BEDROOM
MAIN HOUSE
POWER
1500
gallon
TANK
PROPANE
1000
gallon
TANK
GUEST
HOUSE
2 BEDROOM
EASEMENT DRIVEWAY