LINCOLN COUNTY

DEPARTMENT OF ENVIRONMENTAL HEALTH
WASTEWATER TREATMENT AND DISPOSAL SYSTEM PERMIT

REISSUED TILL 6/25/18

Issue Date: 02/28/07 Expiration Date: ~~03/01/08~~

Property Owner: Kendall Lewis c/o: Renkema²

Address: P.O. Box 1151 Eureka, MT 59917

Telephone: (Home) (Work) 297-2728

Installer: License No.

__XX__ New Installation _____ Existing System

_____ Repair _____ Replacement _____ Extension _____ Other

Describe:

Parcel Description:

Legal: S5 T34 R26

Address or Location: Lot 20 in Whispering Pines

Approved Design Criteria:

Bedrooms 3 Septic Tank Size: 1000 gallons Drainfield Size: 500 Linear Feet

SYSTEM MUST INCLUDE INSTALLATION OF EFFLUENT FILTER AT SEPTIC TANK OUTLET !!

Special Instructions: INSTALL SYSTEM ACCORDING TO LAYOUT, DEQ-4 AND LINCOLN COUNTY WASTEWATER REGULATION #3. ANY DEVIATIONS FROM APPROVED PLAN MUST BE AUTHORIZED BY THE DEPARTMENT.

Issued By: *Kendra J. Lind, R.S.* R.S.

Closure Statement:

I, BUCK SCHERMERHORN *, have inspected this system and found it to be in compliance with the conditions of the permit, and the Lincoln County Wastewater Treatment and Disposal Regulation.*

Signed: Buck Schermerhorn *Date:* 6/15/18

Title: PRESIDENT

NOTICE: The Department must be notified at least 48 hours prior to backfilling the system. Any system not inspected by the Department or its designated representative prior to closure is an illegal installation in violation of Lincoln County Health Board Regulation No. 3. Illegal installations may result in fines and/or requirements to remove or reconstruct the system.

406-293-7781

DISCLAIMER

This permit is not a guarantee by the Department that the system will function properly for a prescribed period of time.

JAKE MERTES 6-5-17
9:09 AM ~ MESSAGE

Wkispering Pines Subdivision
S5, T34N, R26W
Lot 20

⊕ - Perc & Testhole

(A) - Proposed well w/ 100' isolation zone

200' Mixing Zone

Stormwater ditch

xxxx - Strawbales

D/W - Driveway


No wells or septics w/ 100'

No floodplain issues


N


← Groundwater Flow

1" = 200'

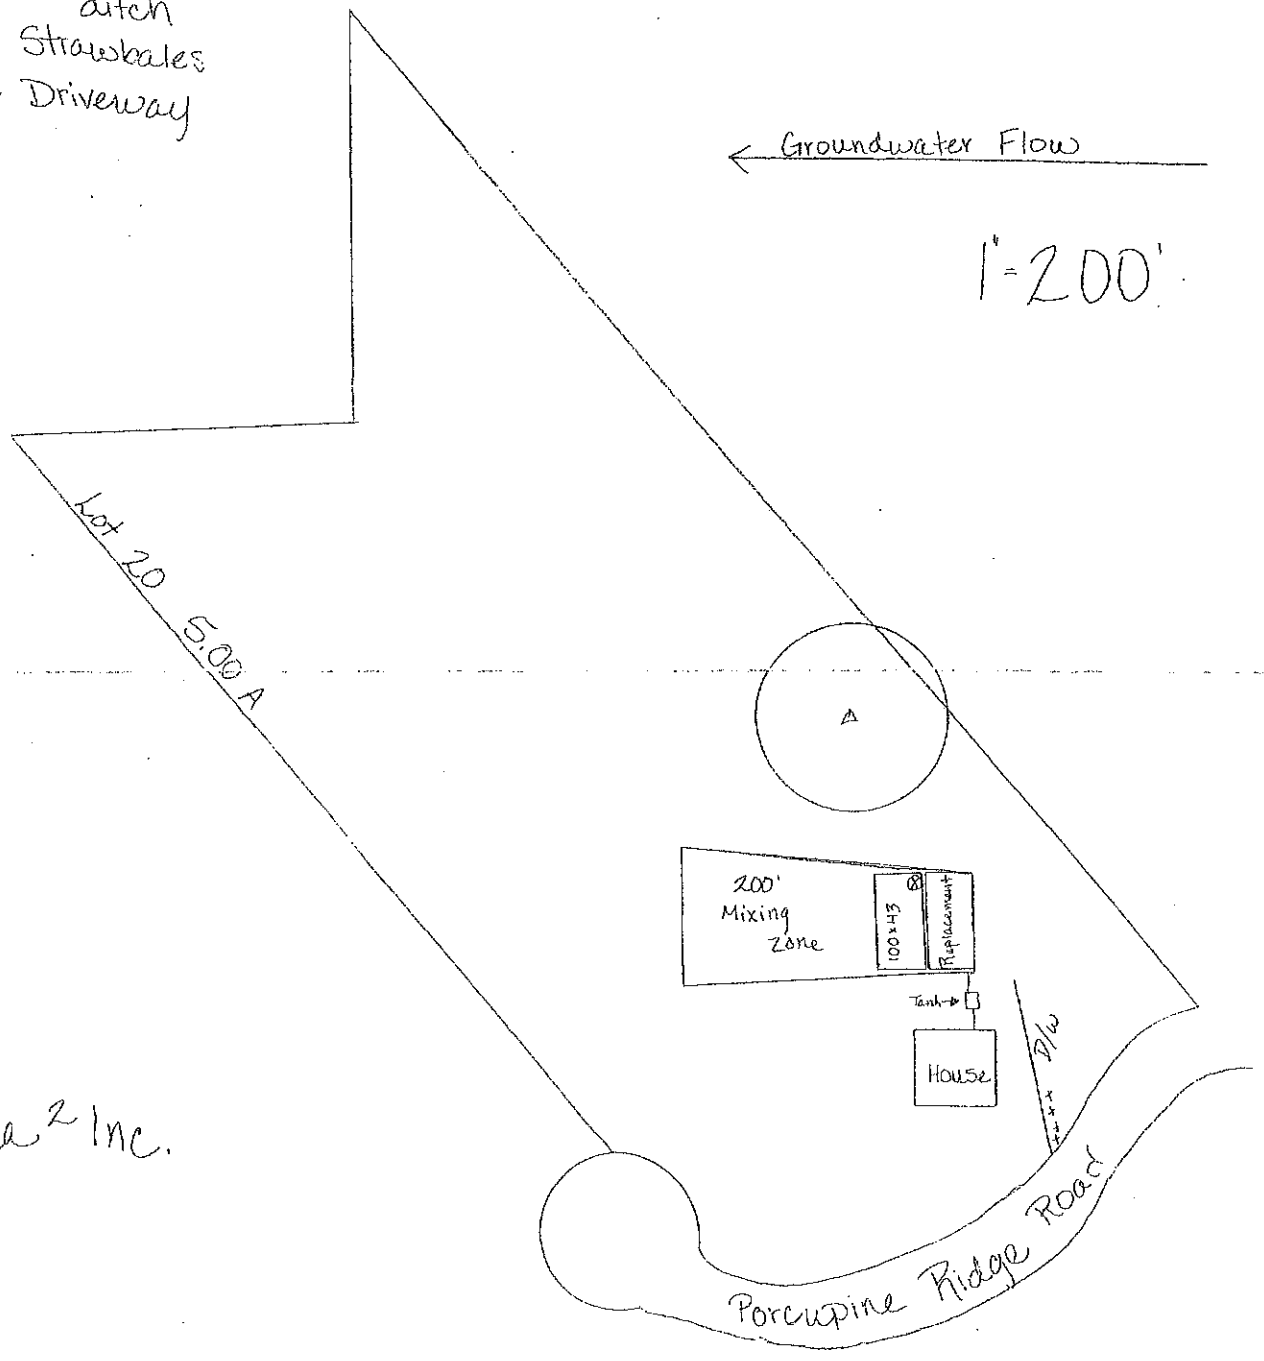

Renkema 2 Inc.

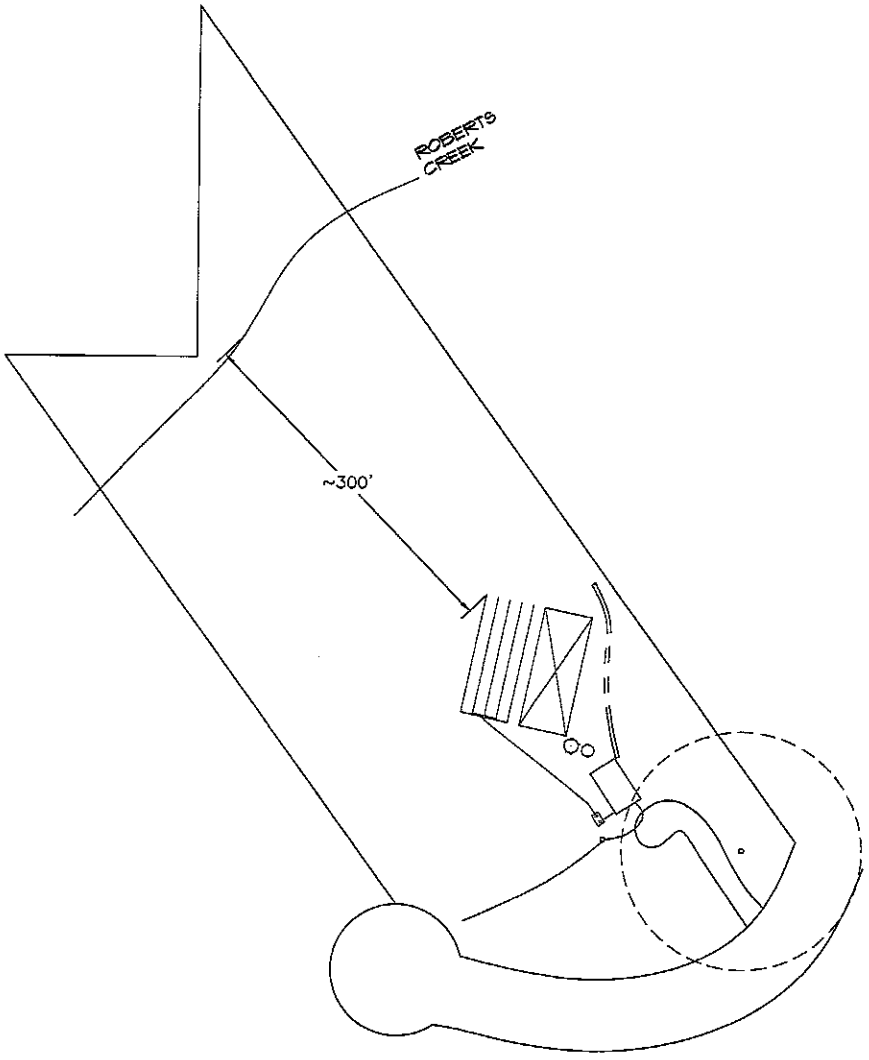

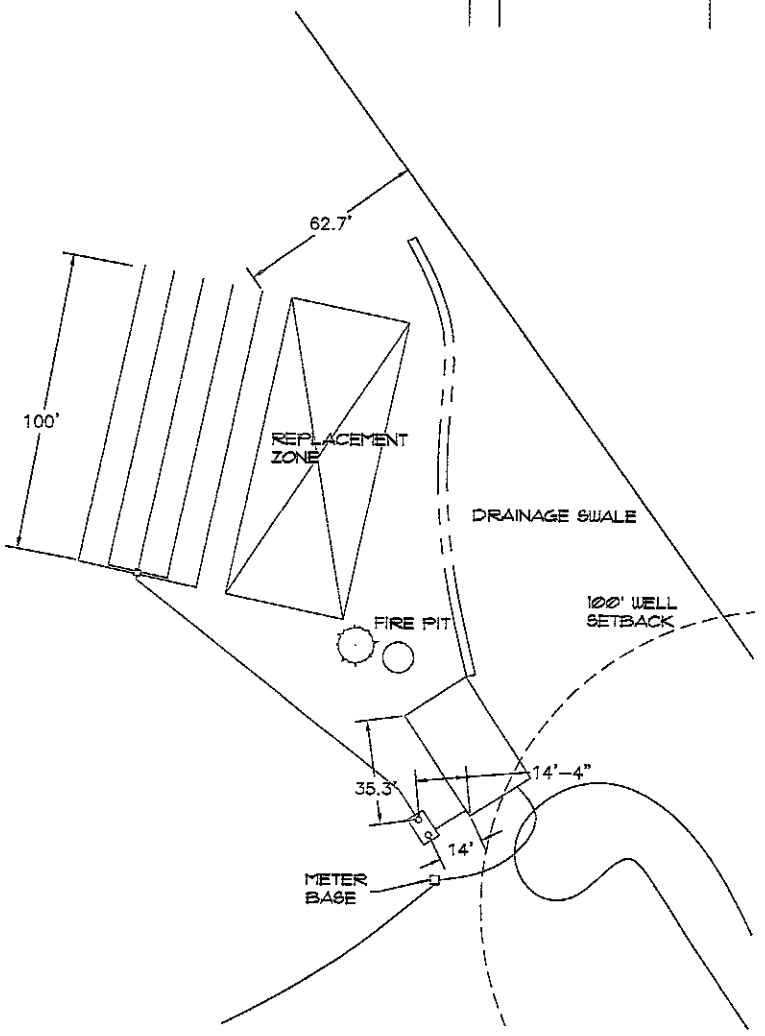

KENNY LEE LEWIS SEPTIC

REV	DESCRIPTION	BY/DATE	APRD/DATE

COMPANY: KEI	SCALE: 1/16 = 1'-0"	KOOCANUSA EXCAVATING LEWIS PROJECT	
CONTRACT: KOO1816	DATE: 5/1/18	SEPTIC AS-BUILT	5/15/18
PLOT FILE: PML-0001	WEIGHT:	DRAWN BY: K. LEWIS	5/15/18
	FINISH:	DRAWING NO.: 02717-001	SHEET NO.: 1

THIS DRAWING IS PROPERTY OF KEI UNDER CONTRACT HAS BEEN SECURED BETWEEN OWNER & KEI IT CAN NOT BE SUBMITTED TO ANY OTHER PARTIES WITHOUT WRITTEN APPROVAL FROM KEI MANAGEMENT