LINCOLN COUNTY
DEPARTMENT OF ENVIRONMENTAL HEALTH
WASTEWATER TREATMENT AND DISPOSAL SYSTEM PERMIT

Issue Date: 11/03/03 Expiration Date: 11/04/04

Property Owner: The Popular Assembly of St. Martin c/o:

Address: [redacted]

Telephone: (Home) [redacted] (Work)

Installer: Lyle P. Weltch License No. 95

__XX__ New Installation _____ Existing System

_____ Repair _____ Replacement _____ Extension _____ Other

Describe:

Parcel Description:

Legal: E-1/2 S19 & W-1/4 S20 T31 R33

Address or Location: Lot 1, Block 5 Wilderness Plateau

Approved Design Criteria:

Bedrooms 3 Septic Tank Size: 1000 gallons Drainfield Size: 200 Linear Feet

SYSTEM MUST INCLUDE INSTALLATION OF EFFLUENT FILTER AT SEPTIC TANK OUTLET !!

Special Instructions: INSTALL SYSTEM ACCORDING TO LAYOUT AND LINCOLN COUNTY WASTEWATER REGULATION #3. ANY DEVIATIONS FROM APPROVED PLAN MUST BE AUTHORIZED BY THE DEPARTMENT.

Issued By: Kendra J. Lind, R.S.

Closure Statement:

I, Robin Blumberg *, have inspected this system and found it to be in compliance with the conditions of the permit, and the Lincoln County Wastewater Treatment and Disposal Regulation.*

Signed: Robin Blumberg R.S. *Date:* 09/02/2025

Title: The system was installed in 2003 and not closed. The tank was pumped and verified. The D-Box & laterals exposed for inspection.

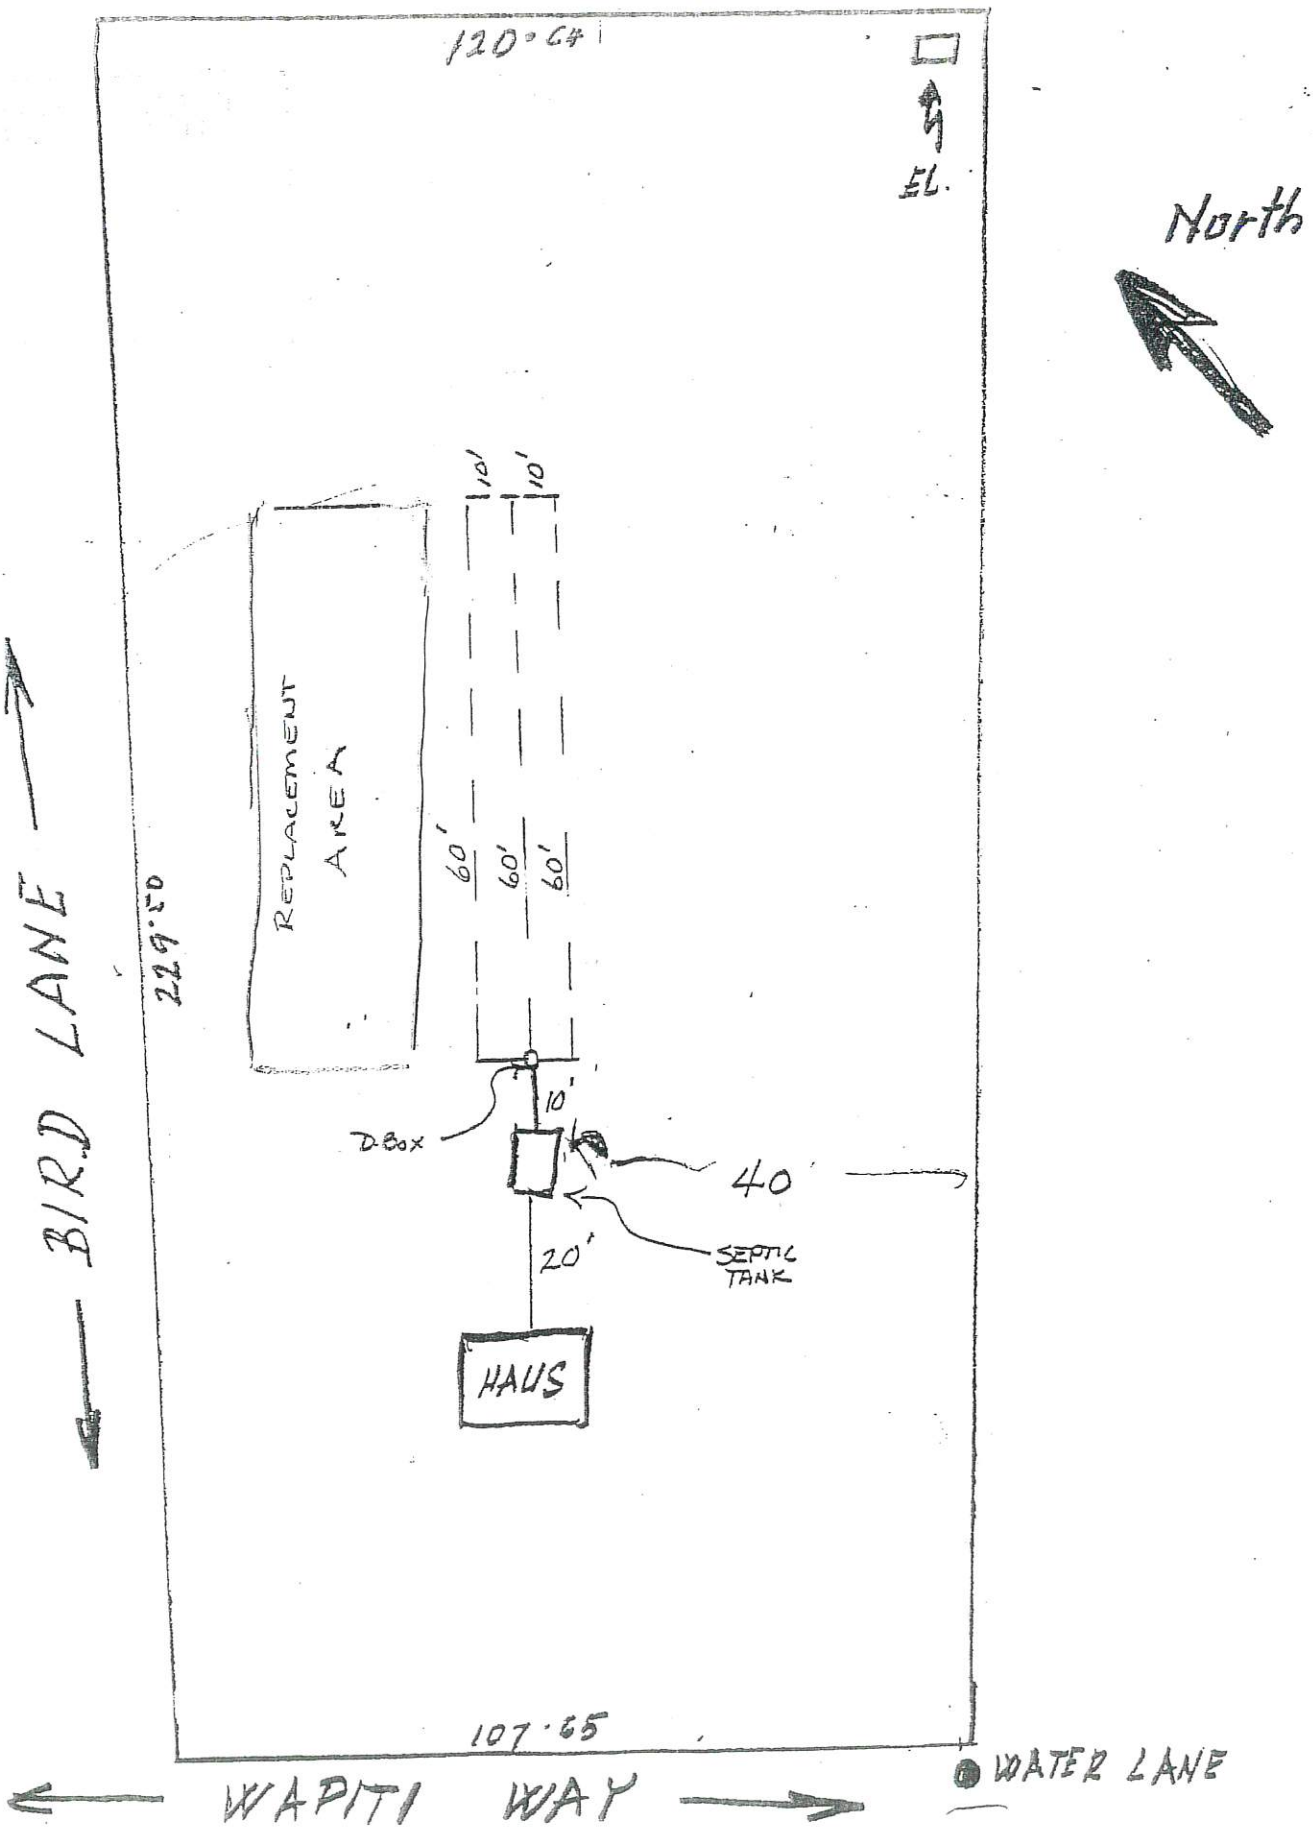
NOTICE: The Department must be notified at least 48 hours prior to backfilling the system. Any system not inspected by the Department or its designated representative prior to closure is an illegal installation in violation of Lincoln County Health Board Regulation No. 3. Illegal installations may result in fines and/or requirements to remove or reconstruct the system.

406-293-7781

DISCLAIMER

This permit is not a guarantee by the Department that the system will function properly for a prescribed period of time.

LOT LAYOUT


120'-0"
EL.
North
BIRD LANE
229.50
REPLACEMENT AREA
10'
10'
60'
60'
60'
10'
D-Box
40'
20'
SEPTIC TANK
HAUS
107.65
WAPITI WAY
WATER LANE