LINCOLN COUNTY
DEPARTMENT OF ENVIRONMENTAL HEALTH
WASTEWATER TREATMENT AND DISPOSAL SYSTEM PERMIT

Issue Date: 7/18/2017 Expiration Date: 7/18/2018

Property Owner: Patrick Broom c/o: Koocanusa Excavating, Inc.

Address: [redacted]

Telephone: (Home) [redacted] (Work)

Installer: Koocanusa Excavating, Inc. License No. 135

__xx__ New Installation ____ Existing System

____ Repair ____ Replacement ____ Extension ____ Other

Describe: Four 97' pressure dosed laterals in 3' wide trenches

Parcel Description:

Legal: S10 T36 R26

Address or Location: Ksanka Foothills Lot 5

Geo/Assessors code: 0000054646

Approved Design Criteria:

Bedrooms 4 Septic Tank Size: 1500/500 gallons Drainfield Size: 389 Linear Feet

SYSTEM MUST INCLUDE INSTALLATION OF EFFLUENT FILTER AT SEPTIC TANK OUTLET !!

Special Instructions: INSTALL SYSTEM ACCORDING TO LAYOUT, DEQ-4 AND LINCOLN COUNTY WASTEWATER REGULATION #3. ANY DEVIATIONS FROM APPROVED PLAN MUST BE AUTHORIZED BY THE DEPARTMENT.

Issued By: Jake Mertes, R.S.

Closure Statement:

I, BUCK SCHERMERHORN, *have inspected this system and found it to be in compliance with the conditions of the permit, and the Lincoln County Wastewater Treatment and Disposal Regulation.*

Signed: Buck Schermerhorn *Date:* 11/30/17


Title: PRESIDENT - #135

NOTICE: The Department must be notified at least 48 hours prior to backfilling the system. Any system not inspected by the Department or its designated representative prior to closure is an illegal installation in violation of Lincoln County Health Board Regulation No. 3. Illegal installations may result in fines and/or requirements to remove or reconstruct the system.

406-283-2442

DISCLAIMER

This permit is not a guarantee by the Department that the system will function properly for a prescribed period of time.

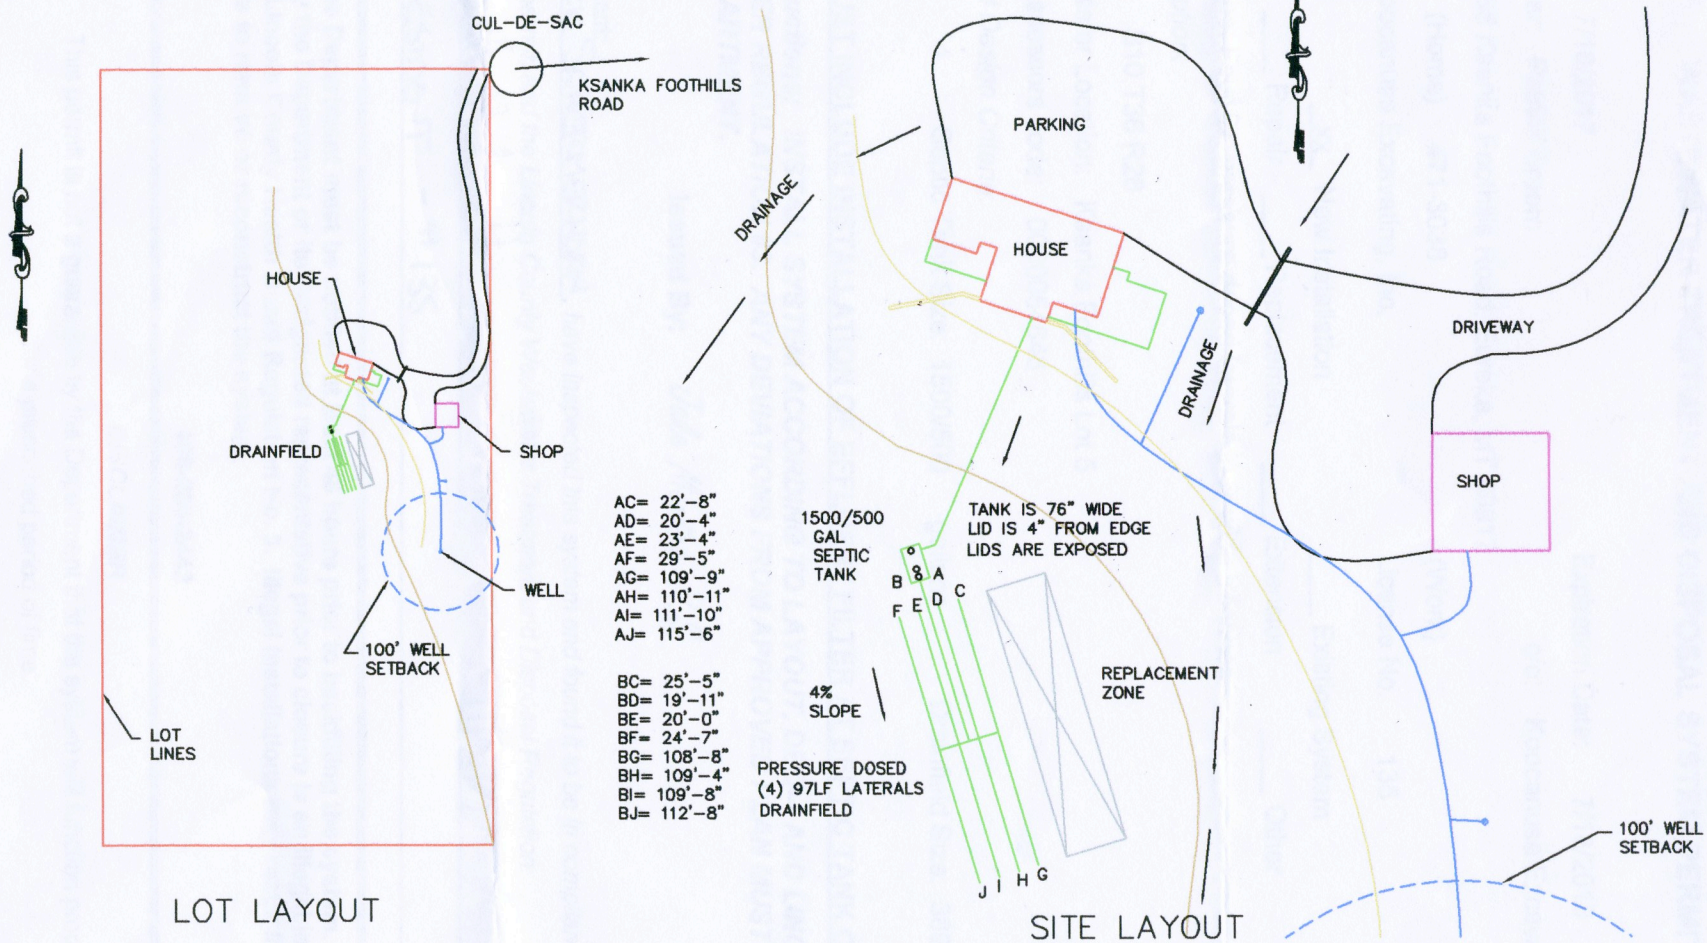

PATRICK BROOM SEPTIC AS-BUILT

REV	DESCRIPTION	BY/DATE	APPR/DATE

COMPANY: KEI	SCALE: 1/16 = 1'-0"	KOOCANUSA EXCAVATING	
CONTRACT:	DATE:	BROOM PROJECT	
VERBAL	1/25/05	SEPTIC AS-BUILT	
PLOT FILE: PMIL-0001	WEIGHT	DRAWN: 6/20/17	
		CHECKED: P. BROOM 6/20/17	
		00517-002	1

THIS DRAWING IS PROPERTY OF KEI (2016). COPYRIGHT HAS BEEN SECURED BETWEEN OWNER & KEI. IT CAN NOT BE SUBMITTED TO ANY OTHER PARTIES WITHOUT WRITTEN APPROVAL FROM KEI MANAGEMENT