County

LINCOLN COUNTY
DEPARTMENT OF ENVIRONMENTAL HEALTH
WASTEWATER TREATMENT AND DISPOSAL SYSTEM PERMIT

Issue Date: 7-7-2015 Expiration Date: 7-8-2016

Property Owner: Corrina & Markay Brown c/o:

Address: [redacted] [redacted]

Telephone: (Home) [redacted] (Work)

Installer: ~~Dennis Redlinger~~ Tally Hoe Tom Cole License No. ~~23~~ 1

x New Installation ____ Existing System

____ Repair ____ Replacement ____ Extension ____ Other

Describe: Drain field and septic to consist of 3x 70 ft lines spaced 10 feet apart

Parcel Description:

Legal: S27 T32 R34

Address or Location: Lot 12 Block 5 – Riverbend homes Forrest Drive

Approved Design Criteria:

Bedrooms 3 Septic Tank Size: 1000 gallons Drainfield Size: 210 Linear Feet

SYSTEM MUST INCLUDE INSTALLATION OF EFFLUENT FILTER AT SEPTIC TANK OUTLET !!

Special Instructions: INSTALL SYSTEM ACCORDING TO LAYOUT, DEQ-4 AND LINCOLN COUNTY WASTEWATER REGULATION #3. ANY DEVIATIONS FROM APPROVED PLAN MUST BE AUTHORIZED BY THE DEPARTMENT.

Issued By: Jake Mertes

Closure Statement:

I, Thomas J Cole, *have inspected this system and found it to be in compliance with the conditions of the permit, and the Lincoln County Wastewater Treatment and Disposal Regulation.*

Signed: Thomas J Cole *Date:* 7-2-16

Title: owner


NOTICE: The Department must be notified at least 48 hours prior to backfilling the system. Any system not inspected by the Department or its designated representative prior to closure is an illegal installation in violation of Lincoln County Health Board Regulation No. 3. Illegal installations may result in fines and/or requirements to remove or reconstruct the system.

406-283-2442

DISCLAIMER

This permit is not a guarantee by the Department that the system will function properly for a prescribed period of time.

LOT LAYOUT
CARL R. TYRA
LOT 12 BLOCK 5
RIVER BEND HOMES

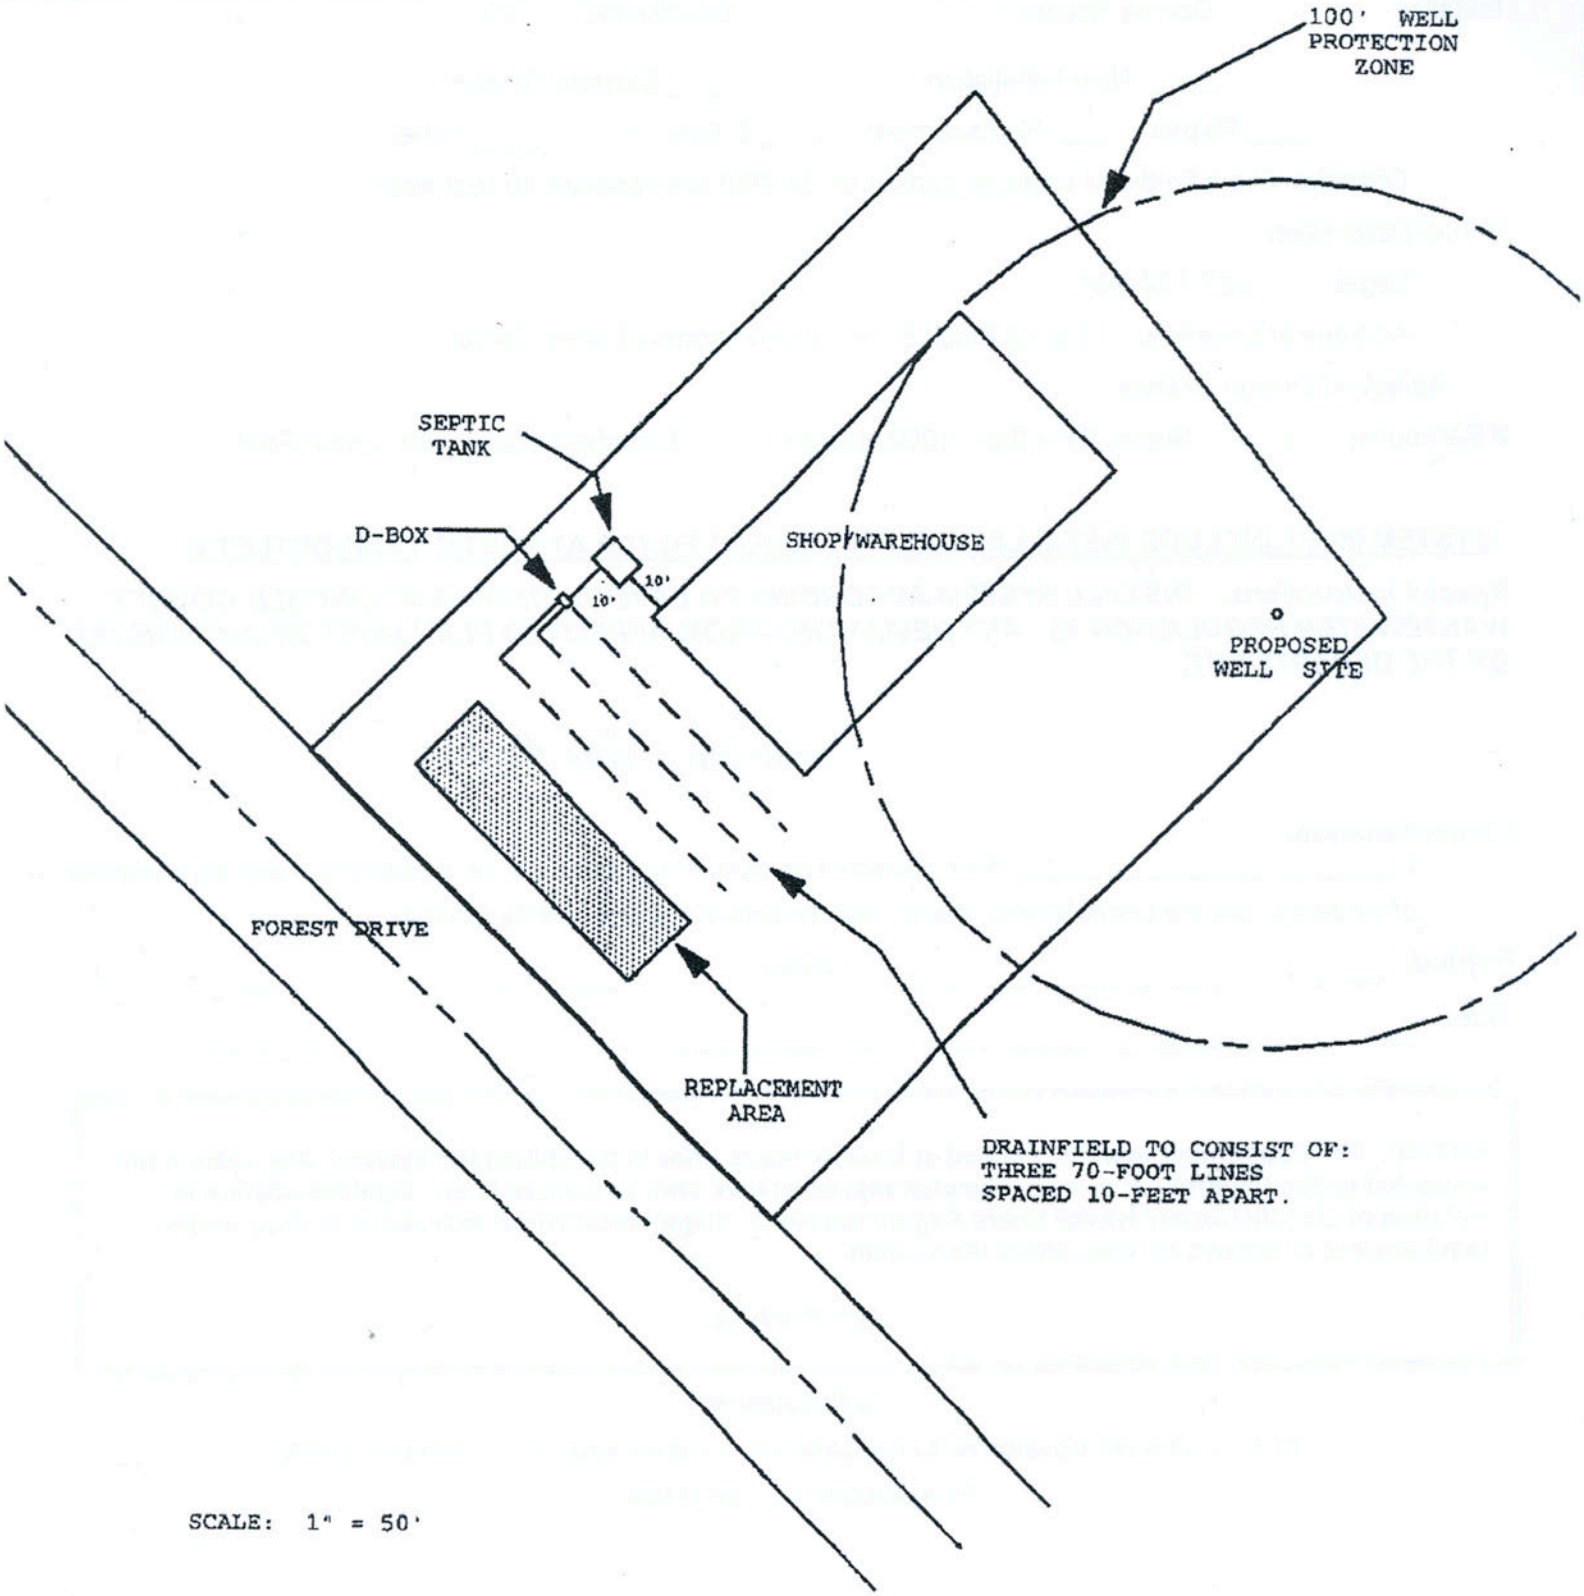

SCALE: 1" = 50'