LINCOLN COUNTY
DEPARTMENT OF ENVIRONMENTAL HEALTH
WASTEWATER TREATMENT AND DISPOSAL SYSTEM PERMIT

Issue Date: 6/2/2016 Expiration Date: 6/2/2017

Property Owner: Kootenai River Outfitters c/o: Robert Winston

Address: PO BOX 775, Troy, MT 59935

Telephone: (Home) [redacted] (Work)

Installer: Thompson Contracting License No. 72

__xx__ New Installation ____ Existing System

____ Repair ____ Replacement ____ Extension ____ Other

Describe: Pressure dosed keyed elevated sand mound (Bed Area 18' x 54') (Basal Area 33' x 69')

Parcel Description:

Legal: S7 T29 R33

Address or Location: Parcel A-1 COS# 3316 550 Hidden Estates Rd.

Geo/Assessors code: 0000052471

Approved Design Criteria:

Design Flow: 750 gallons/day Septic Tank Size: 3(1500) 1(2000) gallons Drainfield Size: 972 Sqft

SYSTEM MUST INCLUDE INSTALLATION OF EFFLUENT FILTER AT SEPTIC TANK OUTLET !!

Special Instructions: INSTALL SYSTEM ACCORDING TO LAYOUT, DEQ-4 AND LINCOLN COUNTY WASTEWATER REGULATION #3. ANY DEVIATIONS FROM APPROVED PLAN MUST BE AUTHORIZED BY THE DEPARTMENT.

Issued By: Jake Mertes, R.S.

Closure Statement:

I, _____, have inspected this system and found it to be in compliance with the conditions of the permit, and the Lincoln County Wastewater Treatment and Disposal Regulation.

Signed: _____ *Date:* _____

Title: _____


NOTICE: The Department must be notified at least 48 hours prior to backfilling the system. Any system not inspected by the Department or its designated representative prior to closure is an illegal installation in violation of Lincoln County Health Board Regulation No. 3. Illegal installations may result in fines and/or requirements to remove or reconstruct the system.

406-283-2442

DISCLAIMER

This permit is not a guarantee by the Department that the system will function properly for a prescribed period of time.

LOT LAYOUT

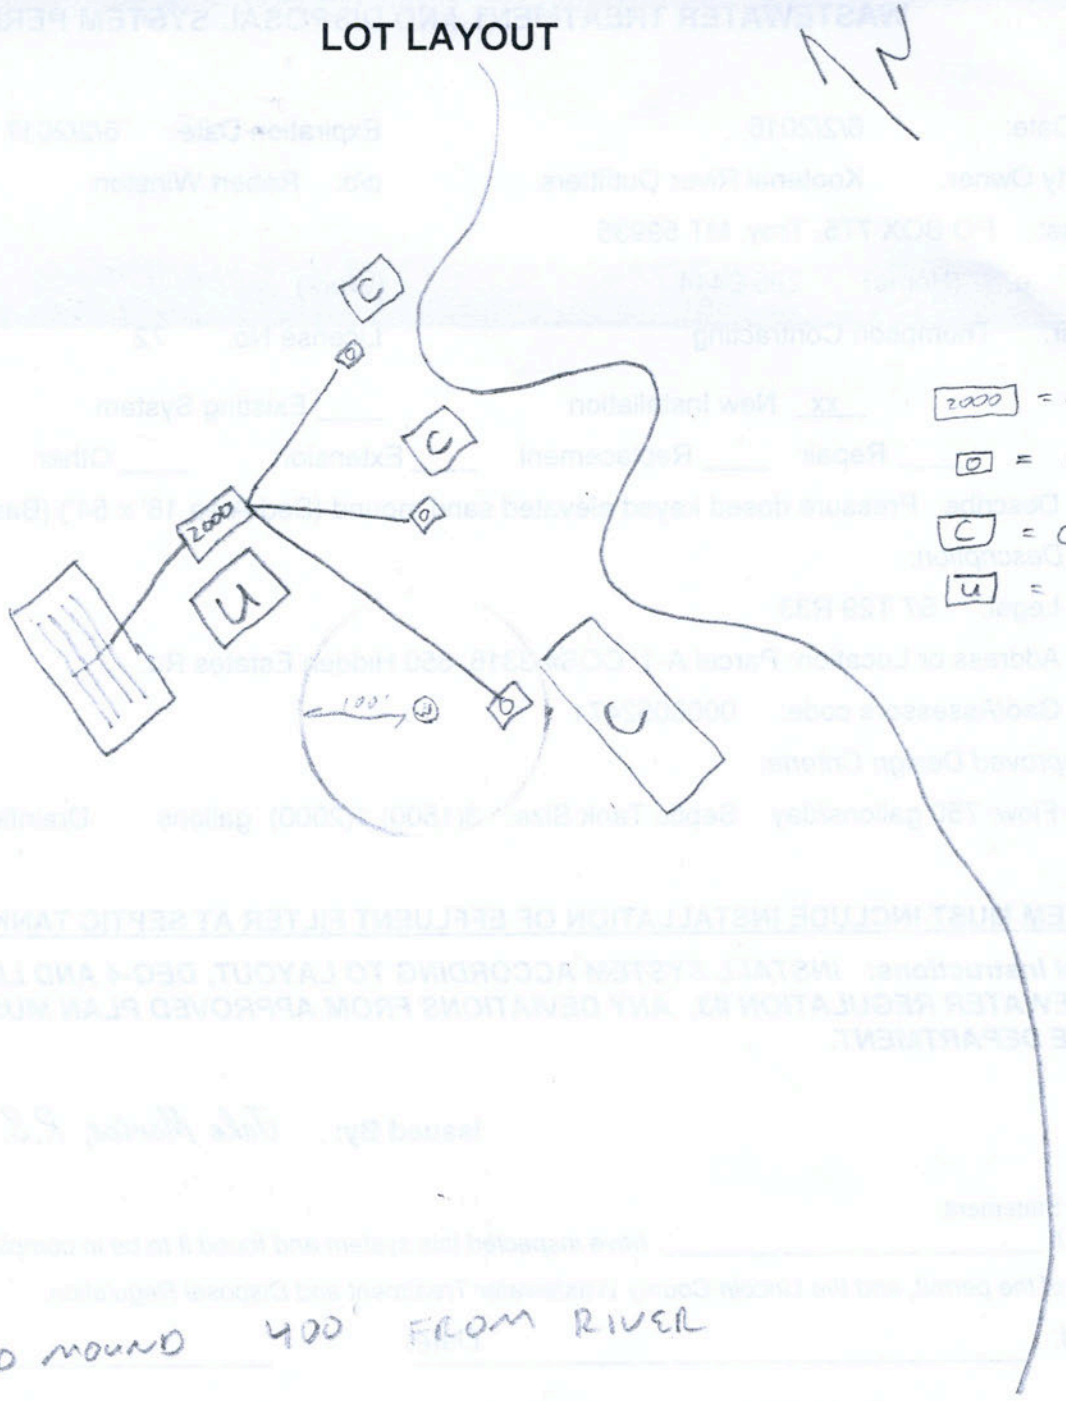

ELEVATED SAND MOUND 400' FROM RIVER

* NOT TO SCALE, PLEASE SUBMIT AS BUILT DRAWING