LINCOLN COUNTY
DEPARTMENT OF ENVIRONMENTAL HEALTH
WASTEWATER TREATMENT AND DISPOSAL SYSTEM PERMIT

Issue Date: 3/9/2016 Expiration Date: 3/10/3017

Property Owner: Steve Lavely c/o: Koocanusa Excavating, Inc.

Address: [redacted]

Telephone: (Home) [redacted] (Work) 250-0436

Installer: Koocanusa Excavating, Inc. License No. 135

____ New Installation ____ Existing System

____ Repair __xx__ Replacement ____ Extension ____ Other

Describe: Replace early 1970's drainfield with three 84' trenches using infiltration galleries.

Parcel Description:

Legal: S33 T37 R27

Address or Location: 1954 Sophie Lake Road

Geo/Assessors code: 0000006847

Approved Design Criteria:

Bedrooms 3 Septic Tank Size: 1000 gallons Drainfield Size: 250 Linear Feet

SYSTEM MUST INCLUDE INSTALLATION OF EFFLUENT FILTER AT SEPTIC TANK OUTLET !!

Special Instructions: INSTALL SYSTEM ACCORDING TO LAYOUT, DEQ-4 AND LINCOLN COUNTY WASTEWATER REGULATION #3. ANY DEVIATIONS FROM APPROVED PLAN MUST BE AUTHORIZED BY THE DEPARTMENT.

Issued By: Jake Mertes, R.S.

Closure Statement:

I, BUCK SCHERMERHORN, *have inspected this system and found it to be in compliance with the conditions of the permit, and the Lincoln County Wastewater Treatment and Disposal Regulation.*

Signed: Buck Schermerhorn *Date:* 3-14-16

Title: PRESIDENT KEI #135


NOTICE: The Department must be notified at least 48 hours prior to backfilling the system. Any system not inspected by the Department or its designated representative prior to closure is an illegal installation in violation of Lincoln County Health Board Regulation No. 3. Illegal installations may result in fines and/or requirements to remove or reconstruct the system.

406-283-2442

DISCLAIMER

This permit is not a guarantee by the Department that the system will function properly for a prescribed period of time.

LOT LAYOUT

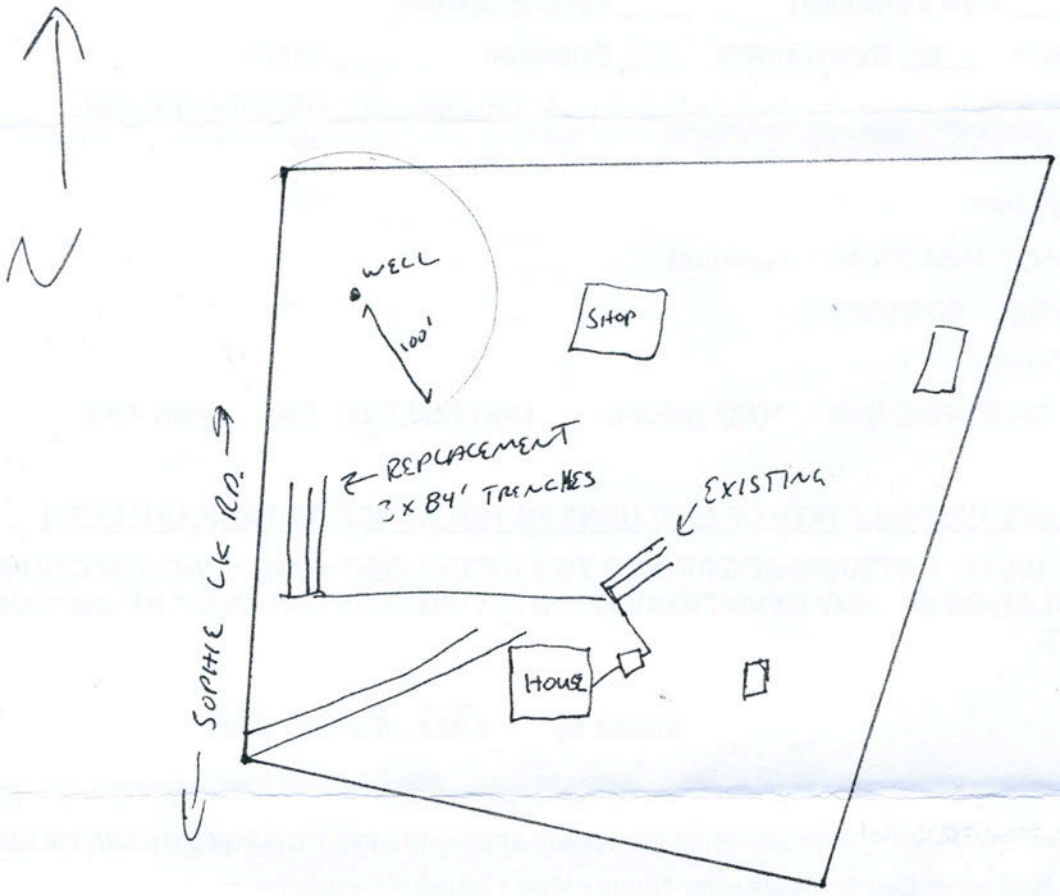
N
WELL
100'
SHOP
REPLACEMENT
3 x 84' TRENCHES
EXISTING
SOPHIE CK RD.
HOUSE




NORTH

DISTANCES:

A–E= 82'–5"
A–D= 18'–6"
B–E= 85'–0"
B–D= 13'–6"
C–E= 87'–10"
C–D= 12'–8"
H–K= 13'–4"
H–J= 8'–5"
G–K= 19'–10"
G–J= 9'–4"
F–K= 28'–2"
F–J= 15'–4"

D–BOX LID= 40"

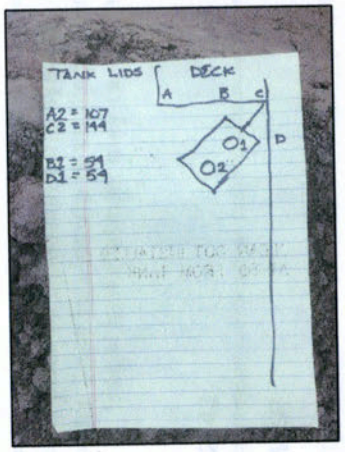

SEPTIC TANK LID LOCATIONS

LAVELY DRAINFIELD AS-BUILT DRAWING

REV	DATE	COMPANY	SCALE:	KOOCANUSA EXCAVATING LAVELY PROJECT
		KEI	1/16 = 1'0"	SEPTIC LAYOUT
		DRAWN	DATE:	3/2/16
		VERIFIED	3/2/16	S. LAVELY 3/2/16
		PLOT FILE:	WEIGHT:	00516-002 1
		P16_-0001		

THIS DRAWING IS PROPERTY OF KEI CIVIL CONTRACTOR AND EACH HOLDER ASSUMES OWNER & KEI IT CAN NOT BE SUBMITTED TO ANY OTHER PERSONS WITHOUT WRITTEN APPROVAL FROM KEI UNDERSIGNED

⑥ ⑤ ④ ③ ②