LINCOLN COUNTY
DEPARTMENT OF ENVIRONMENTAL HEALTH
WASTEWATER TREATMENT AND DISPOSAL SYSTEM PERMIT

Issue Date: 3/8/2017 Expiration Date: 3/8/2018

Property Owner: Charles Nash c/o: Barb Renkema

Address: PO BOX 1693

Telephone: (Home) [redacted] (Work)

Installer: ~~Renkema~~ Bob Cuffe License No. ~~78~~ 133

__xx__ New Installation ____ Existing System

____ Repair ____ Replacement ____ Extension ____ Other

Describe: Three 85' laterals using gravelless chambers. Size reduced per 0.5 app rate.

Parcel Description:

Legal: S13 T36 R28

Address or Location: Dukes Vista Subdivision Lot 5-B 20.26 Acres

Geo/Assessors code: 0000012613

Approved Design Criteria:

Bedrooms 3 Septic Tank Size: 1000 gallons Drainfield Size: 255 Linear Feet

SYSTEM MUST INCLUDE INSTALLATION OF EFFLUENT FILTER AT SEPTIC TANK OUTLET !!

Special Instructions: INSTALL SYSTEM ACCORDING TO LAYOUT, DEQ-4 AND LINCOLN COUNTY WASTEWATER REGULATION #3. ANY DEVIATIONS FROM APPROVED PLAN MUST BE AUTHORIZED BY THE DEPARTMENT.

Issued By: Jake Mertes, R.S.

Closure Statement:

I, Robert Cuffe, *have inspected this system and found it to be in compliance with the conditions of the permit, and the Lincoln County Wastewater Treatment and Disposal Regulation.*

Signed: _____ *Date:* 12/5/17

Title: President, Glacier Excavating, Inc

NOTICE: The Department must be notified at least 48 hours prior to backfilling the system. Any system not inspected by the Department or its designated representative prior to closure is an illegal installation in violation of Lincoln County Health Board Regulation No. 3. Illegal installations may result in fines and/or requirements to remove or reconstruct the system.

406-283-2442


DISCLAIMER

This permit is not a guarantee by the Department that the system will function properly for a prescribed period of time.

Charles Nash

S13-T36N-R26W

Duke's Vista

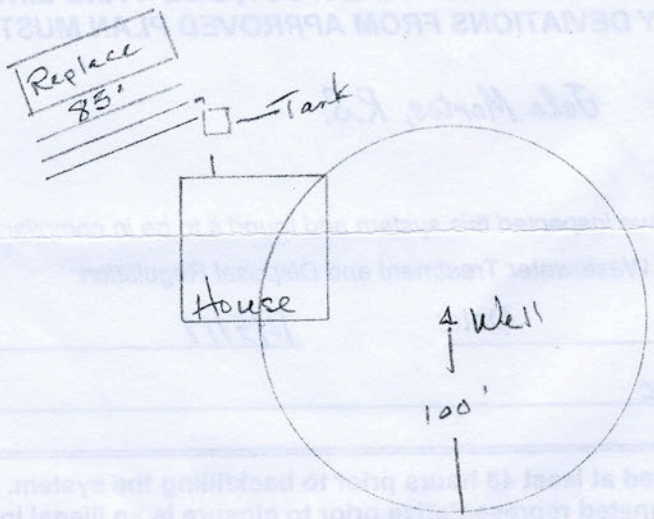

1" = 100'

N

20 A