LINCOLN COUNTY
DEPARTMENT OF ENVIRONMENTAL HEALTH
WASTEWATER TREATMENT AND DISPOSAL SYSTEM PERMIT

Issue Date: 7/24/2015

Expiration Date: 7/25/2016

Property Owner: Utter

c/o: Enviro-tech

Address: PO BOX 175 Eureka, MT 59917

Telephone: (Home) [redacted]

(Work)

Installer: ~~Buck Schermerhorn~~ Rocky Mountain Plumbing & Electric

License No. ~~135~~ E

_x_ New Installation

____ Existing System

____ Repair ____ Replacement ____ Extension ____ Other

Describe: 3 66' trenches using gravelless chambers. Reduction in sizing allowed per App rate.

Parcel Description:

Legal: Western Addition Lots 42, 43, & 44 S23 T36 R27

Address or Location: Eureka, MT

Approved Design Criteria:

Bedrooms 3 Septic Tank Size: 1000 gallons Drainfield Size: 200 Linear Feet

SYSTEM MUST INCLUDE INSTALLATION OF EFFLUENT FILTER AT SEPTIC TANK OUTLET !!

Special Instructions: INSTALL SYSTEM ACCORDING TO LAYOUT, DEQ-4 AND LINCOLN COUNTY WASTEWATER REGULATION #3. ANY DEVIATIONS FROM APPROVED PLAN MUST BE AUTHORIZED BY THE DEPARTMENT.

Issued By: Jake Mertes

Closure Statement:

I, Michael B Mahon, *have inspected this system and found it to be in compliance with the conditions of the permit, and the Lincoln County Wastewater Treatment and Disposal Regulation.*

Signed: Michael B Mahon *Date:* 28 MAR 2016

Title: Installer #6

NOTICE: The Department must be notified at least 48 hours prior to backfilling the system. Any system not inspected by the Department or its designated representative prior to closure is an illegal installation in violation of Lincoln County Health Board Regulation No. 3. Illegal installations may result in fines and/or requirements to remove or reconstruct the system.

406-283-2442


DISCLAIMER

This permit is not a guarantee by the Department that the system will function properly for a prescribed period of time.

Legend

- test hole
- proposed drainfield site
- proposed replacement area
- proposed well site w/ 100' isolation zone
- mixing zone

Name: Utter
County: Lincoln
Location: sec.23-T36N-R27W
E.Q.#

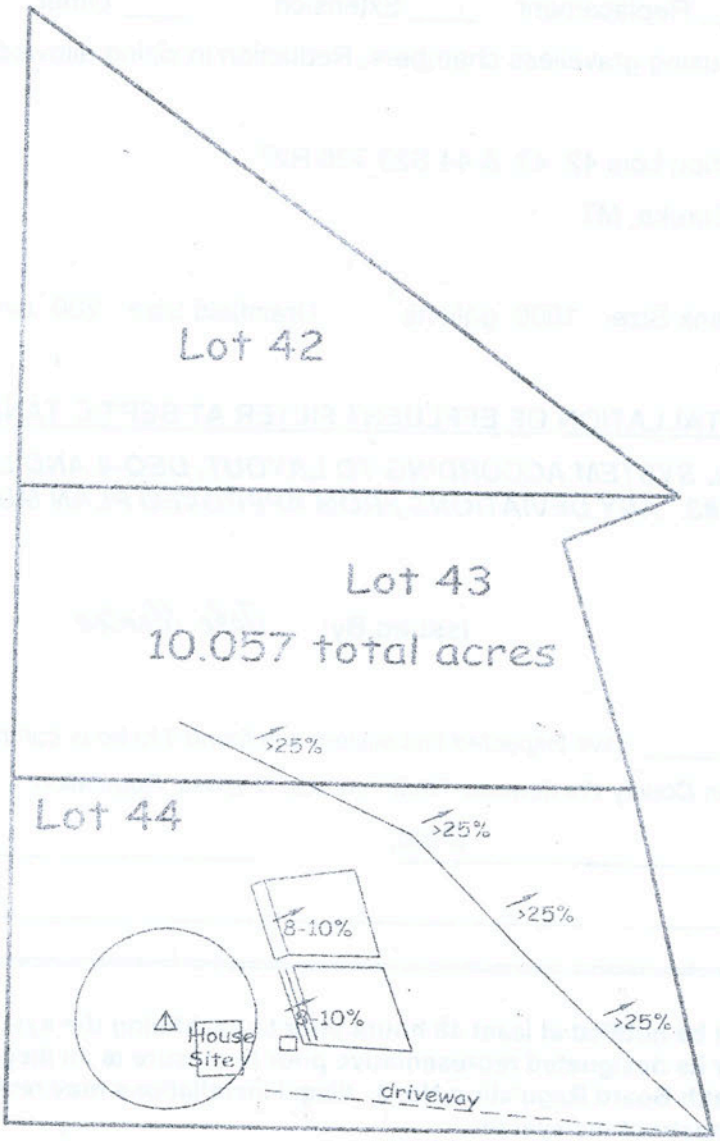

Enviro-Tech
Consulting Inc.
PO Box 5674
Kalispell, MT 59903
(406)257-2795

N

1" = 200'