LINCOLN COUNTY
DEPARTMENT OF ENVIRONMENTAL HEALTH
WASTEWATER TREATMENT AND DISPOSAL SYSTEM PERMIT

Issue Date: 11/17/2014 Expiration Date: 11/18/2015

Property Owner: Catherine Huth & Terri Cole c/o:

Address: [redacted]

Telephone: (Home) [redacted] (Work) [redacted]

Installer: Bob Cuffe License No. 141

__XX__ New Installation _____ Existing System

_____ Repair _____ Replacement _____ Extension _____ Other

Describe: Site moved to comply with requirements of GLID due to canal ditch that transects property. Installing elevated sand mound to fit adequately sized system in space available

Parcel Description:

Legal: S25 T36 R26

Address or Location: Lot 1 of Timber Glen Subdivision

Approved Design Criteria:

Bedrooms: 5 Septic Tank Size: 1500 gallons Absorption Bed Size: 512 Square Feet

Dosing Tank Size: 500 gallons Total Mound Size: Approx. 48' x 32'

SYSTEM MUST INCLUDE INSTALLATION OF EFFLUENT FILTER AT SEPTIC TANK OUTLET !!

Special Instructions: INSTALL ELEVATED SAND MOUND ACCORDING TO LAYOUT, PLAN DETAILS, DEQ-4 AND LINCOLN COUNTY WASTEWATER REGULATION #3. ANY DEVIATIONS FROM APPROVED PLAN MUST BE AUTHORIZED BY THE DEPARTMENT.

Issued By: Kendra J. Lind, R.S.

Closure Statement:

I, BUCK SCHERMERHORN, *have inspected this system and found it to be in compliance with the conditions of the permit, and the Lincoln County Wastewater Treatment and Disposal Regulation.*

Signed: Buck Schermerhorn *Date:* 10/29/15


Title: PRESIDENT

NOTICE: The Department must be notified at least 48 hours prior to backfilling the system. Any system not inspected by the Department or its designated representative prior to closure is an illegal installation in violation of Lincoln County Health Board Regulation No. 3. Illegal installations may result in fines and/or requirements to remove or reconstruct the system.

406-283-2442

DISCLAIMER

This permit is not a guarantee by the Department that the system will function properly for a prescribed period of time.

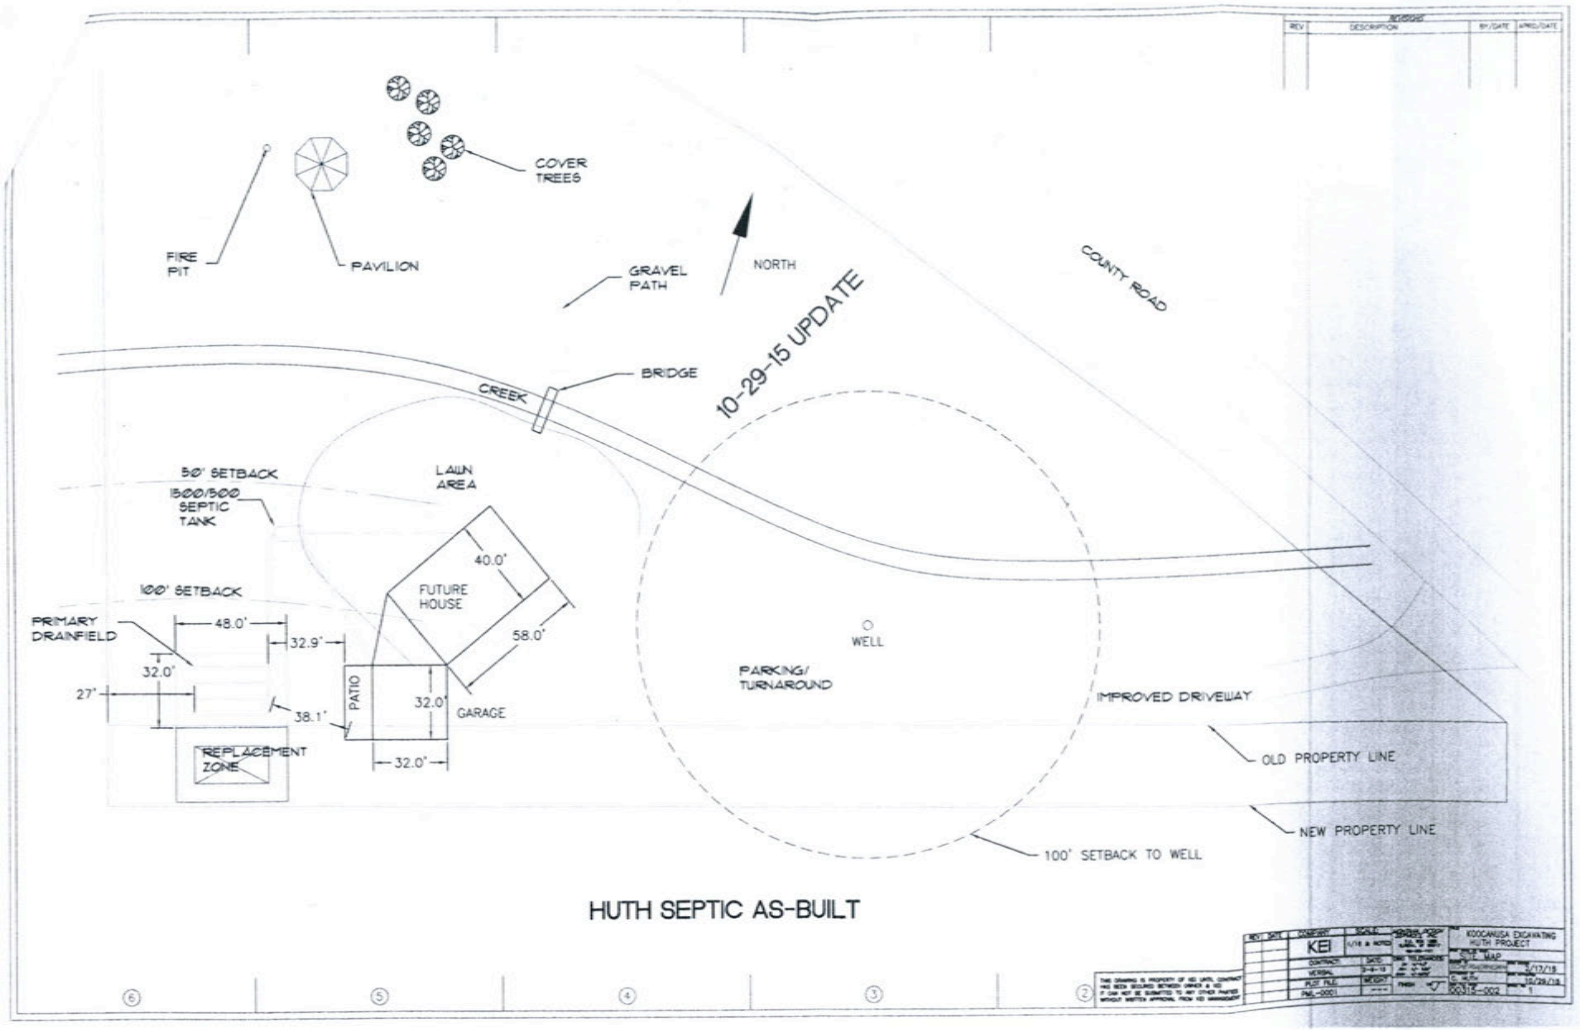

HUTH SEPTIC AS-BUILT