LINCOLN COUNTY
DEPARTMENT OF ENVIRONMENTAL HEALTH
WASTEWATER TREATMENT AND DISPOSAL SYSTEM PERMIT

Issue Date: 05/14/2014 Expiration Date: 05/15/2015

Property Owner: Tony Smith c/o:

Address: [redacted]

Telephone: (Home) [redacted] (Work)

Installer: Keith Mack License No. 111

__XX__ New Installation _____ Existing System

_____ Repair _____ Replacement _____ Extension _____ Other

Describe: Sand-Lined system required. Using gravelless chambers – sizing reduction allowed per "Drainfield Size" below.

Parcel Description:

Legal: S22 T37 R31

Address or Location: Lot 2 in Silvertip Ranch

Approved Design Criteria:

Bedrooms: 3 Septic Tank Size: 1000 gallons Drainfield Size: 144 Linear Feet

SYSTEM MUST INCLUDE INSTALLATION OF EFFLUENT FILTER AT SEPTIC TANK OUTLET !!

Special Instructions: INSTALL SAND-LINED SYSTEM ACCORDING TO LAYOUT, DEQ-4 AND LINCOLN COUNTY WASTEWATER REGULATION #3. ANY DEVIATIONS FROM APPROVED PLAN MUST BE AUTHORIZED BY THE DEPARTMENT.

Issued By: *Kendra J. Lind, R.S.*

Closure Statement:

I, _____, have inspected this system and found it to be in compliance with the conditions of the permit, and the Lincoln County Wastewater Treatment and Disposal Regulation.

Signed: _____ *Date:* _____

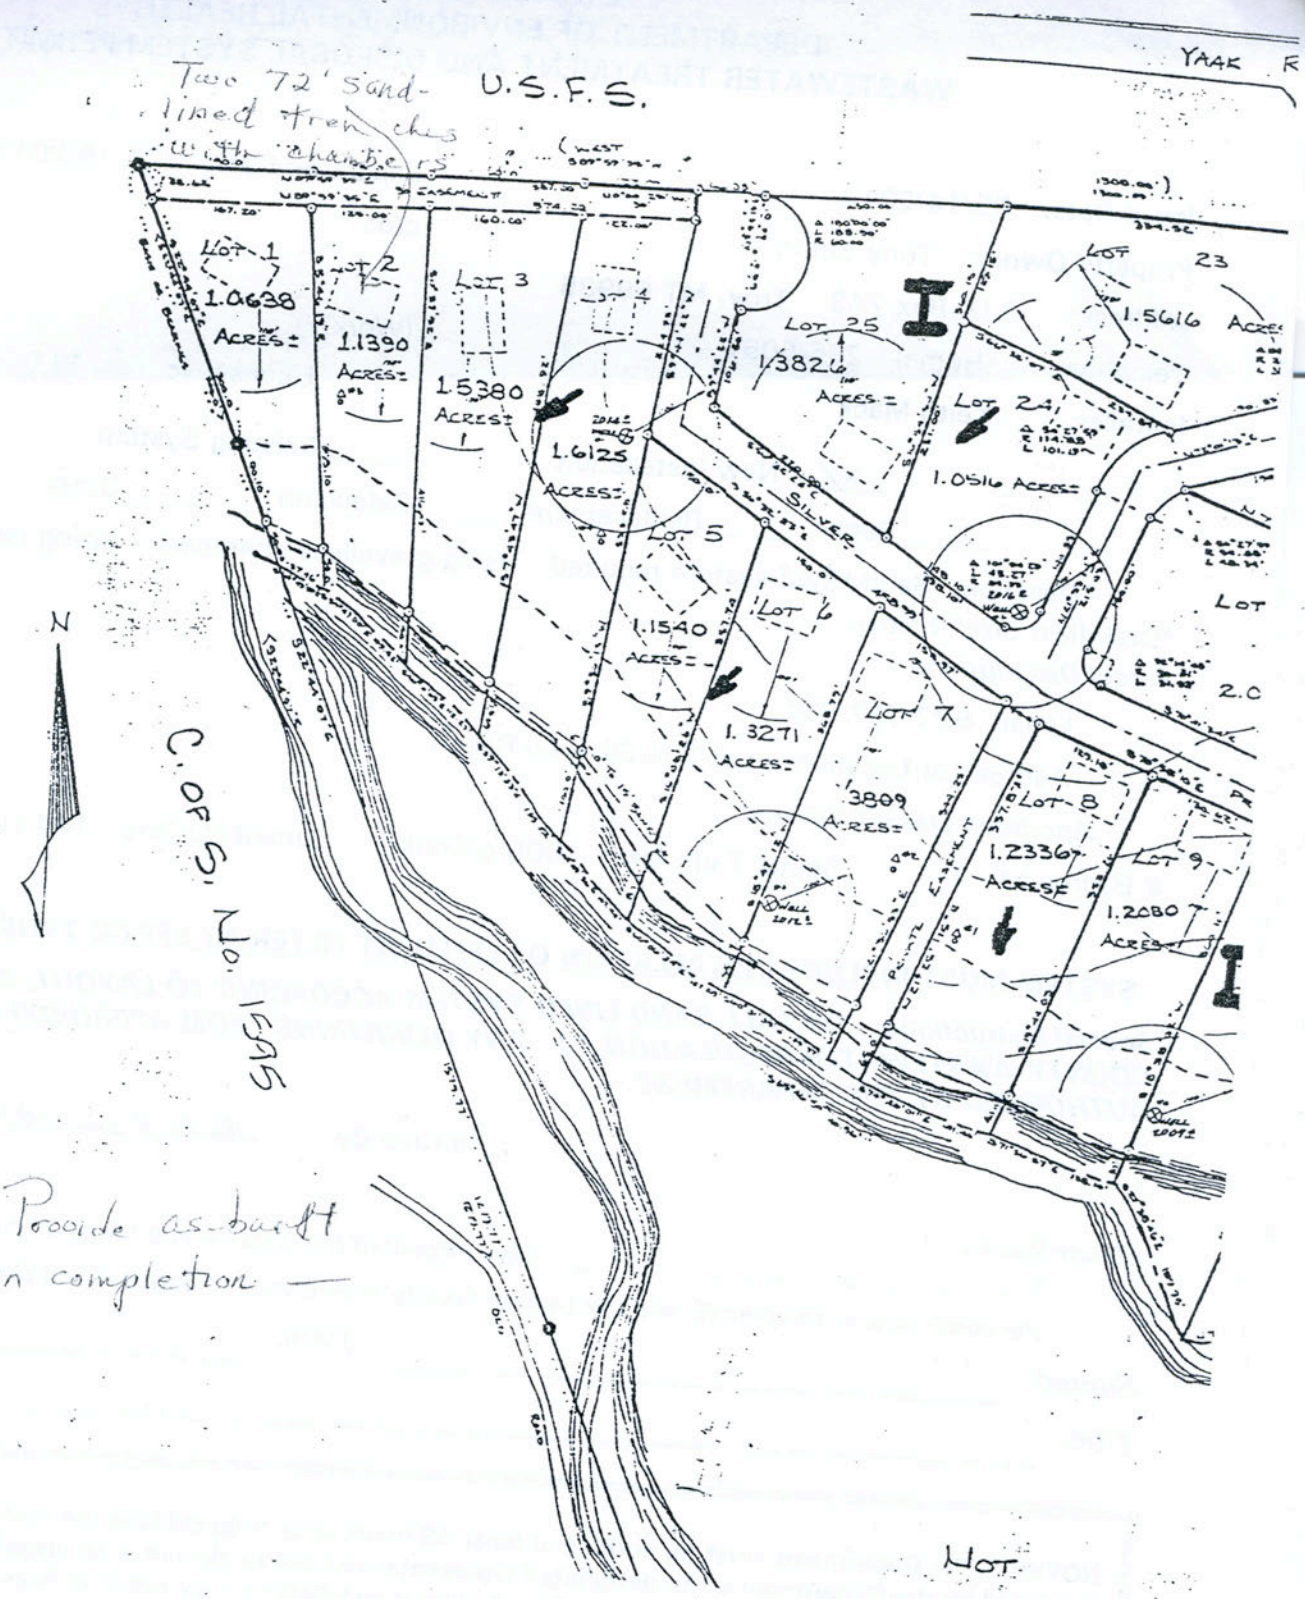
Title: _____

NOTICE: The Department must be notified at least 48 hours prior to backfilling the system. Any system not inspected by the Department or its designated representative prior to closure is an illegal installation in violation of Lincoln County Health Board Regulation No. 3. Illegal installations may result in fines and/or requirements to remove or reconstruct the system.

406-283-2442

DISCLAIMER

This permit is not a guarantee by the Department that the system will function properly for a prescribed period of time.


Two 72' sand-lined trenches with chambers
U.S.F.S.
YAAK
LOT 1
1.0638 ACRES=
LOT 2
1.1390 ACRES=
LOT 3
1.5380 ACRES=
LOT 4
1.6125 ACRES=
LOT 5
1.1540 ACRES=
LOT 6
1.3271 ACRES=
LOT 7
3809 ACRES=
LOT 8
1.23367 ACRESE
LOT 9
1.2080 ACRES=
LOT 25
1.3826 ACRES=
LOT 24
1.0516 ACRES=
LOT 23
1.5616 ACRES=
SILVER
N
C. OF S. NO. 1595
Provide as-built on completion —
LOT