LINCOLN COUNTY
DEPARTMENT OF ENVIRONMENTAL HEALTH
WASTEWATER TREATMENT AND DISPOSAL SYSTEM PERMIT

Issue Date: 10/27/2008 Expiration Date: 10/28/2009

Property Owner: Kevin Kurucz c/o: Koocanusa Excavating

Address: [redacted]

Telephone: (Cell) 250-0436 (Work) [redacted]

Installer: Koocanusa Excavating License No. 135

XX New Installation _____ Existing System

_____ Repair _____ Replacement _____ Extension _____ Other

Describe: Using Gravelless chambers for installation -- 15% sizing reduction allowed as indicated by drainfield sizing below.

Parcel Description:

Legal: SE-1/4 SW-1/4 S14 T36 R28

Address or Location: Lot 1 of Sapphire Heights

Approved Design Criteria:

Bedrooms 3 Septic Tank Size: 1000 gallons Drainfield Size: 258 Linear Feet

SYSTEM MUST INCLUDE INSTALLATION OF EFFLUENT FILTER AT SEPTIC TANK OUTLET !!

Special Instructions: INSTALL SYSTEM ACCORDING TO LAYOUT, DEQ-4 AND LINCOLN COUNTY WASTEWATER REGULATION #3. ANY DEVIATIONS FROM APPROVED PLAN MUST BE AUTHORIZED BY THE DEPARTMENT.

Issued By: Kendra J. Lind, R.S.

Closure Statement:
I, DUCK SCHERMERHORN *, have inspected this system and found it to be in compliance with the conditions of the permit and the Lincoln County Wastewater Treatment and Disposal Regulation.*

Signed: [signature] *Date:* 11/10/08

Title: 135 PRESIDENT

NOTICE: The Department must be notified at least 48 hours prior to backfilling the system. Any system not inspected by the Department or its designated representative prior to closure is an illegal installation in violation of Lincoln County Health Board Regulation No. 3. Illegal installations may result in fines and/or requirements to remove or reconstruct the system.

406-293-7781

DISCLAIMER


This permit is not a guarantee by the Department that the system will function properly for a prescribed period of time.

LOT 1


20.06 ACRES
6869 BLACK LAKE RD, REXFORD, MT 59930
S14, T36N, R28W, SAPPHIRE HEIGHTS
ASSESSMENT #0000054836
GEO 56-4822-14-3-04-20-0000

DRAINFIELD SIZING

(3) BEDROOM= 300 GPD
300 GPD/0.5 APP=600 SQFT
600 SQ FT/2' CHAMBERS= 300 LF
REDUCTION FOR 0.5 APP= 15%
300' X 0.85= 255 LF= (3) 86' LATERALS

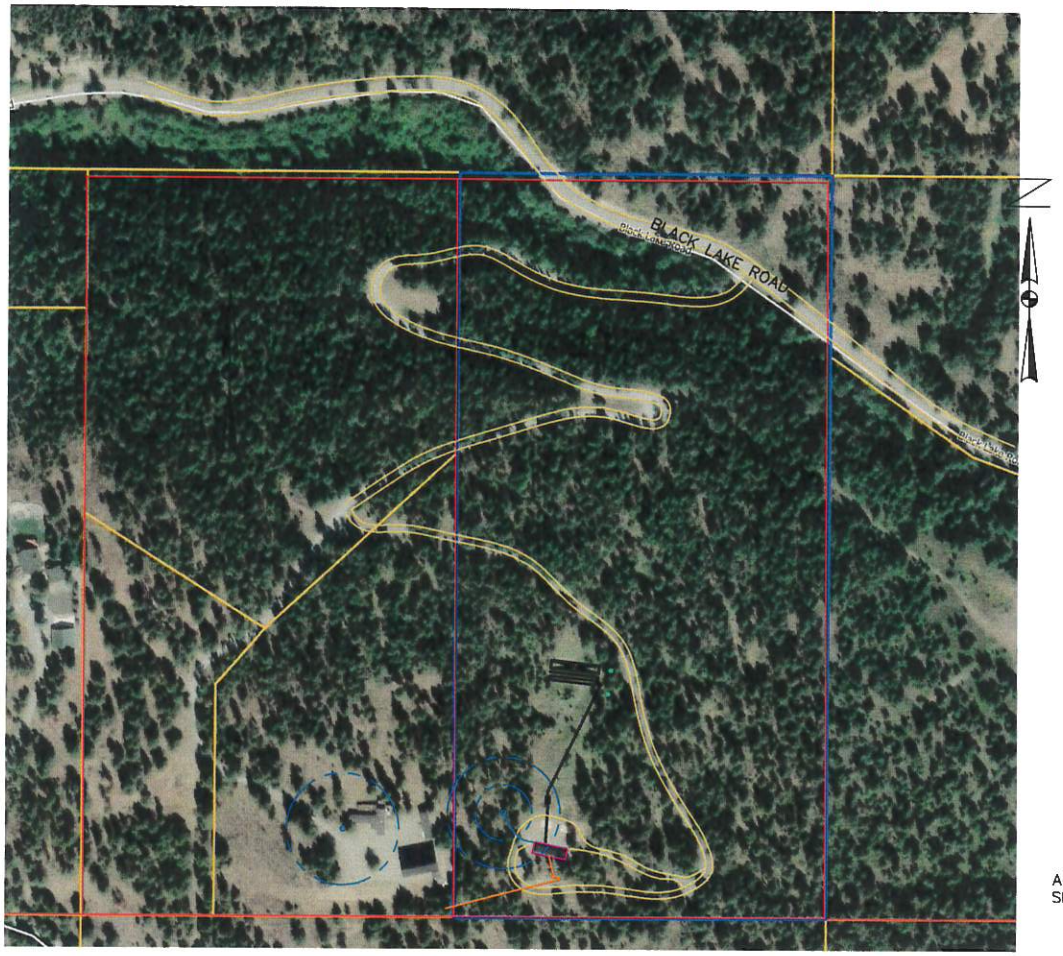

6869 BLACK LAKE RD SITE LAYOUT

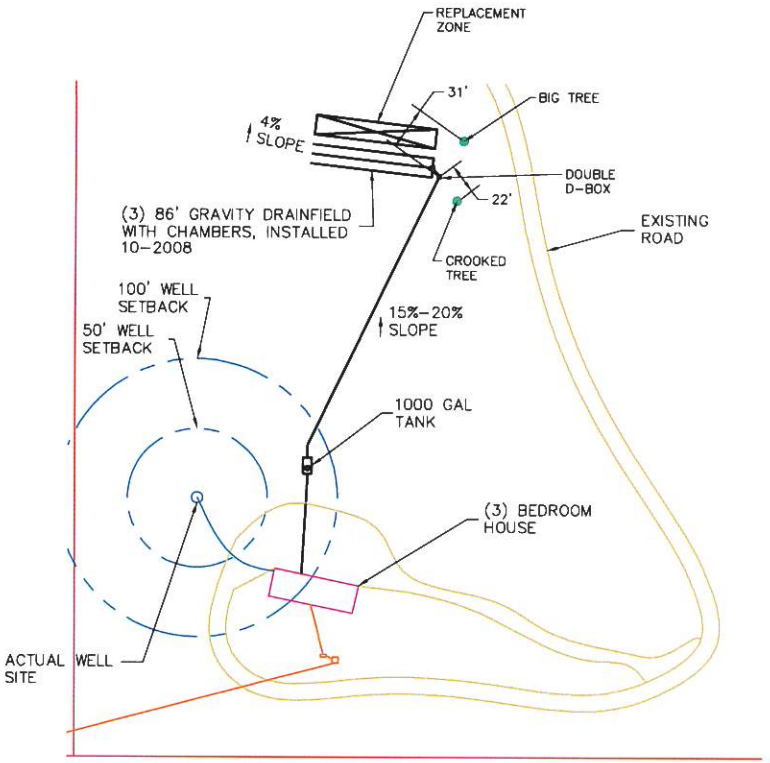

DRAINFIELD LAYOUT

REV	DATE	COMPANY	SCALE	DESIGN / DRAWN	KOOCANUSA EXCAVATING KURUCZ PROJECT
		KEI	1/16 & NOTED		AS-BUILT SEPTIC
		CONTRACT:	DATE:	CHK TOLERANCES:	9/26/08
		VERBAL	1/23/08		9/26/08
		PLOT FILE:	WEIGHT	FINISH	B. LINNELL
		PML-0001	---		06408-1

⑥ ⑤ ④ ③ ②