PERMIT

Issue Date: 07/27/00 Expiration Date: 07/28/01

Property Owner: Johann Weinfurtner c/o: Burt Braach

Address: [redacted]

Telephone: (Home) _____ (Work) _____

Installer: ~~Bert Braach~~ IVAN MILLER, JR. License No. ~~79~~ 52

XX New Installation _____ Existing System

_____ Repair _____ Replacement _____ Extension _____ Other

Describe: _____

Parcel Description:

Legal: SE 1/4 S14 T37 R28

Address or Location: Lot 4 in Kootenai Acres

Approved Design Criteria:

Bedrooms 3 Septic Tank Size: 1000 gallons Drainfield Size: 285 lineal feet

INSTALL SYSTEM ACCORDING TO LOT LAYOUT AND LINCOLN COUNTY WASTEWATER REGULATION #3.

Special Instructions: ***ANY DEVIATIONS FROM APPROVED PLAN MUST BE AUTHORIZED BY THE DEPARTMENT.***

Issued By: *Kendra J. Lind, R.S.*

Closure Statement:


I, Ivan Miller Jr. *, have inspected this system and found it to be in compliance with the conditions of the permit and the Lincoln County Wastewater Treatment and Disposal Regulation.*

Signed: Ivan Miller *Date:* 9-14-00

Title: installer

LOT LAYOUT
JOHANN WEINFURTNER
SE 1/4 S14 T37 R28
LOT 4
KOOTENAI ACRES

Revised 9/13/00
- J.W.P.

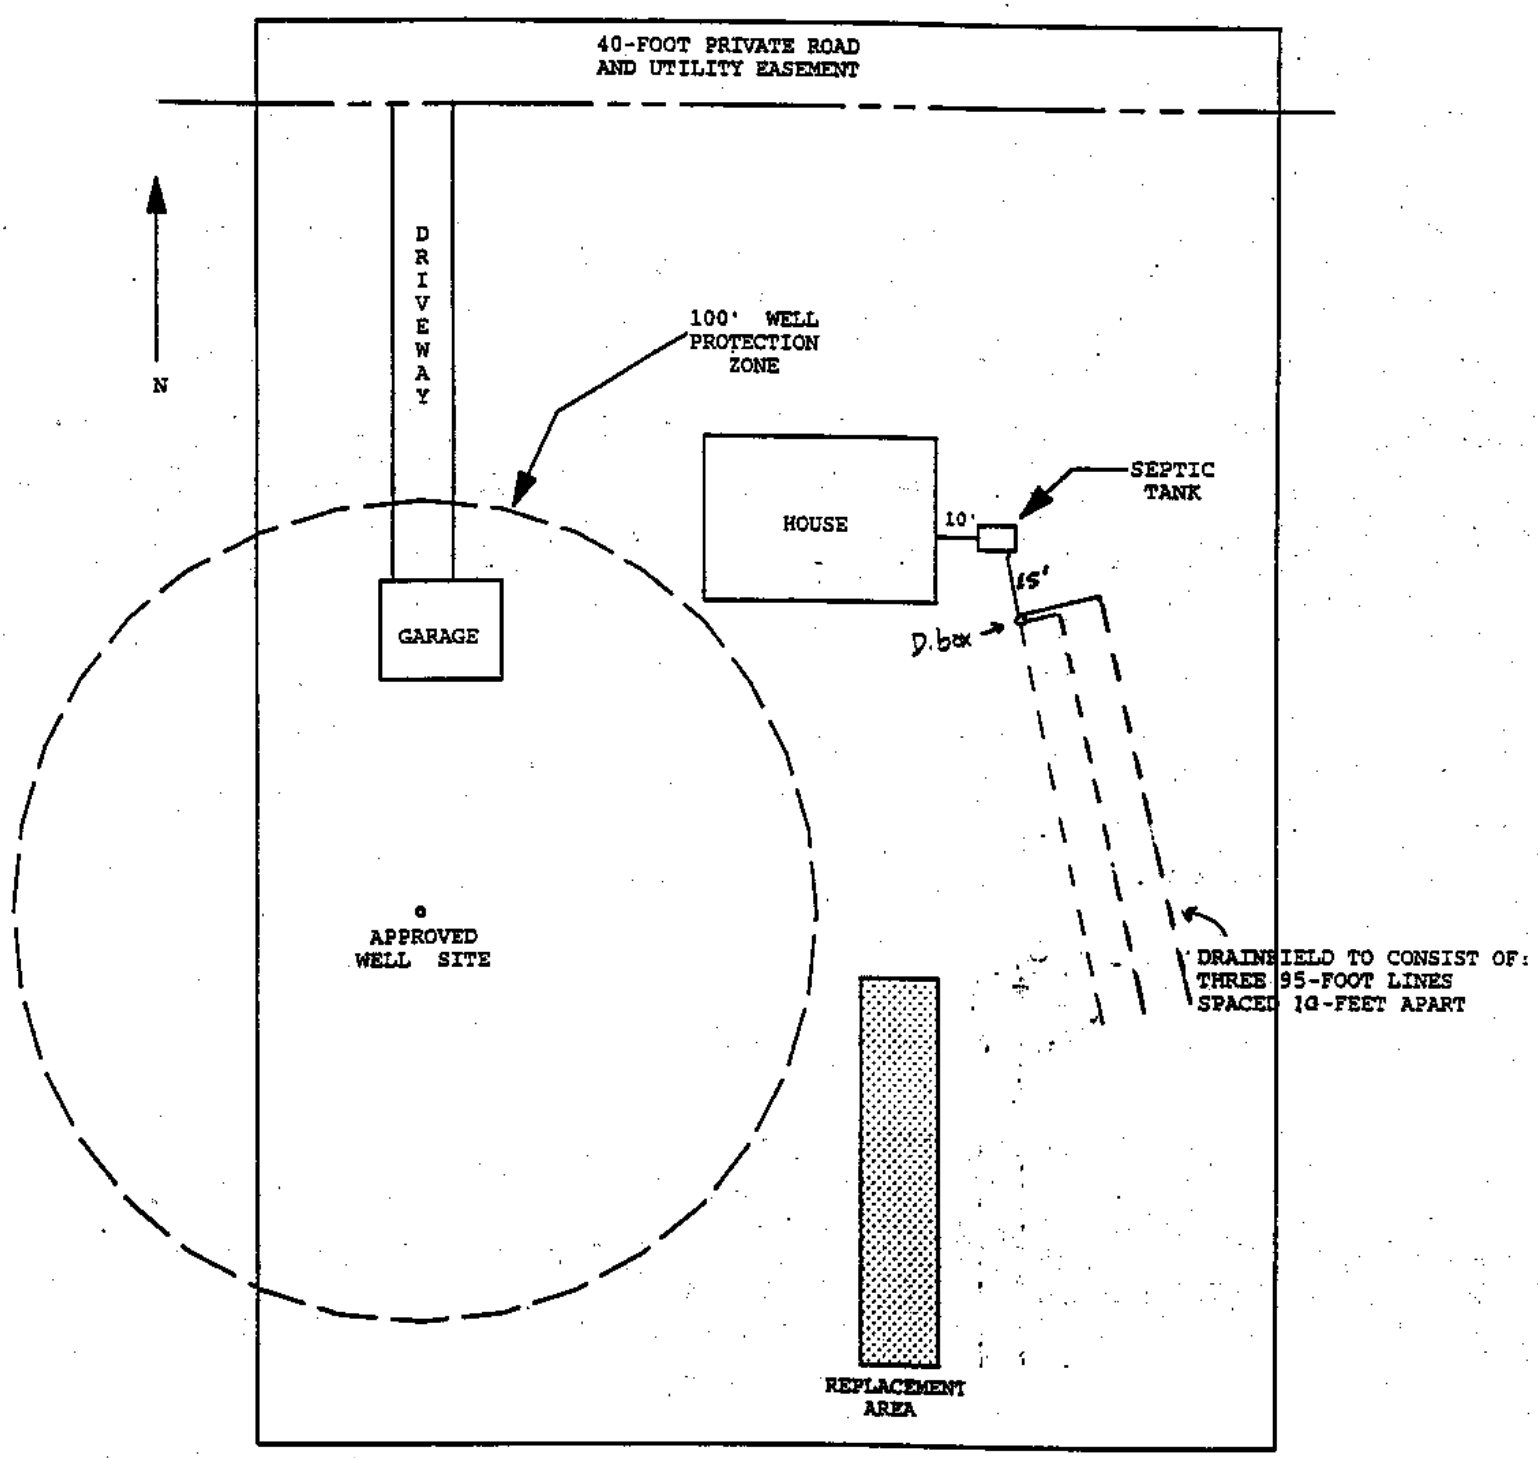

SCALE: 1" = 50'